


Section 29 Township 18 Range 11-W

Well Number 1-State Bank

Company Bradley Oil

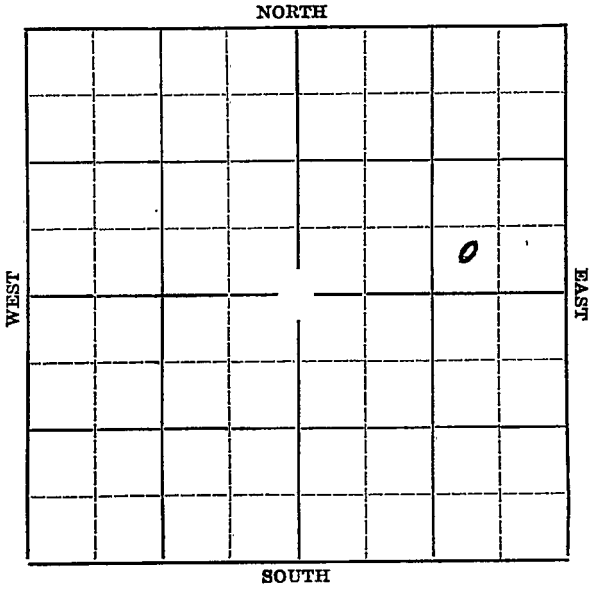

KANSAS

Map No. \_\_\_\_\_ Sec. 29 Twp. 18 R. 11-W

Well No. 1-State Bank Farm \_\_\_\_\_

Bradley Oil Company \_\_\_\_\_

NORTH

|  |  |  |  |   |  |
|--|--|--|--|---|--|
|  |  |  |  |   |  |
|  |  |  |  |   |  |
|  |  |  |  |   |  |
|  |  |  |  | 0 |  |
|  |  |  |  |   |  |
|  |  |  |  |   |  |
|  |  |  |  |   |  |
|  |  |  |  |   |  |

WEST

EAST

SOUTH

\_\_\_\_\_ Ft. from N. Line

330 Ft. from S. Line

990 Ft. from E. Line

\_\_\_\_\_ Ft. from W. Line

Elev. 1822

Date  
1936

REPORT

4/15 Location

4/23 R.O.G.

4/30 --

5/7 Rig.

5/14 --

5/21 Rigging up.

5/28 Shut down.

6/4-- 6/11--6/18--6/25--7/2--7/9--

7/15/36-Rig.

D & A

ABANDONED ~~ABANDONED~~ ABANDONED



1937

2/3 Conglomerate 3400'.

H.F.W. 3428'.

T. D. 3542'. Abandoned.

**ABANDONED**

Map No. 55 Sec. 29 Twp. 18 R. 11WWell No. 1 State Bank.Bradley Oil Company

Contractor

## SECTION PLAT

..... Ft. from N. Line

380 Ft. from S. Line990 Ft. from E. Line

..... Ft. from W. Line

|  |  |  |   |
|--|--|--|---|
|  |  |  |   |
|  |  |  |   |
|  |  |  | 0 |
|  |  |  |   |
|  |  |  |   |

## FIRST REPORT

Location..... ✓

Rig up.....

Drilling and Remarks:

## RECORD

Cased..... in., ..... ft.

Sand.....

Gas.....

Oil.....

Total Depth.....

## PRODUCTION

1st 24 hrs. Nat.....

1st 24 hrs. after shot.....

Gas..... Cu. Ft.

Dry Hole.....

Abandoned.....

Date

APR 15 1936

192.....

S. J. LEWIS

Scout

KANSAS

Map No. 55 Sec. 29 Twp. 18 R. 11WWell No. State Bank.Bradley Oil Company

Contractor

## SECTION PLAT

|  |  |  |   |
|--|--|--|---|
|  |  |  |   |
|  |  |  | 0 |
|  |  |  |   |
|  |  |  |   |

\_\_\_\_\_ Ft. from N. Line

330 Ft. from S. Line990 Ft. from E. Line

\_\_\_\_\_ Ft. from W. Line

ABANDONED

Location \_\_\_\_\_

Rig up \_\_\_\_\_

Drilling and Remarks:

*Rig*  
*A. H.*

## RECORD

Cased \_\_\_\_\_ in., \_\_\_\_\_ ft.

Sand \_\_\_\_\_

Gas \_\_\_\_\_

Oil \_\_\_\_\_

Total Depth \_\_\_\_\_

## PRODUCTION

1st 24 hrs. Nat. \_\_\_\_\_

1st 24 hrs. after shot \_\_\_\_\_

Gas \_\_\_\_\_ Cu. Ft.

Dry Hole \_\_\_\_\_

Abandoned \_\_\_\_\_

Date

JUL 15 1936 19

S. J. LEWIS Scout

# KANSAS

Form 26—1M Bks.—2-29

*Carlton*

*11W*

Map No. 55 Sec. 29 Twp. 18 R. 11W

Well No. 1 State Bank

Bradley Oil & Gas Company  
Contractor

### SECTION PLAT

|  |  |  |   |
|--|--|--|---|
|  |  |  |   |
|  |  |  |   |
|  |  |  | o |
|  |  |  |   |
|  |  |  |   |

\_\_\_\_\_ Ft. from N. Line

320 Ft. from S. Line

990 Ft. from E. Line

\_\_\_\_\_ Ft. from W. Line

### FIRST REPORT

Location \_\_\_\_\_

Rig up \_\_\_\_\_

Drilling and Remarks:

*Rig*

### RECORD

Cased \_\_\_\_\_ in., \_\_\_\_\_ ft.

Sand \_\_\_\_\_

Gas \_\_\_\_\_

Oil \_\_\_\_\_

Total Depth \_\_\_\_\_

### PRODUCTION

1st 24 hrs. Nat. \_\_\_\_\_

1st 24 hrs. after shot \_\_\_\_\_

Gas \_\_\_\_\_ Cu. Ft.

Dry Hole \_\_\_\_\_

Abandoned \_\_\_\_\_

Date

OCT 21 1936<sub>19</sub>

S. J. LEWIS Scout

Map No. 55 Sec. 29 Twp. 18 R. 11W

Well No. 1 State Bank

Bradley Oil Company

Contractor

SECTION PLAT

|  |  |  |   |
|--|--|--|---|
|  |  |  |   |
|  |  |  | 0 |
|  |  |  |   |
|  |  |  |   |

\_\_\_\_\_ Ft. from N. Line

330 Ft. from S. Line

990 Ft. from E. Line

\_\_\_\_\_ Ft. from W. Line

ABANDONED

Location \_\_\_\_\_

Rig up \_\_\_\_\_

Drilling and Remarks:

*Conglomerate*  
*3400*

*HFW 3428*

*JJA*

RECORD

Cased \_\_\_\_\_ in., \_\_\_\_\_ ft.

Sand \_\_\_\_\_

Gas \_\_\_\_\_

Oil \_\_\_\_\_

Total Depth 2542

PRODUCTION

1st 24 hrs. Nat. \_\_\_\_\_

1st 24 hrs. after shot \_\_\_\_\_

Gas \_\_\_\_\_ Cu. Ft.

Dry Hole \_\_\_\_\_

Abandoned \_\_\_\_\_

Date

FEB 3 1937 19

S. J. LEWIS Scout