

Barton


KANSAS

Form 51-5M-11-38-Palace

Section 11 Township 20 Range 11-W

Well No. 12 Kowalsky

Company Stanolind

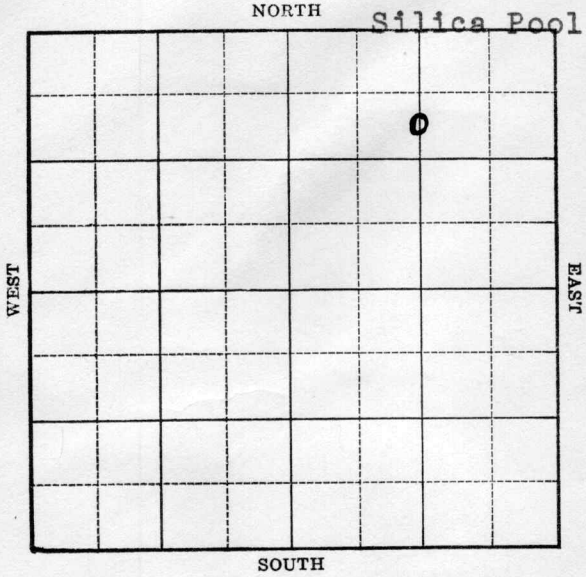

1939

3/22

7" - 3375'

Basal 3815'

T. D. 3872'

Input: 165 water in 30 minutes.

Could not fill casing.

SALT WATER DISPOSAL:

ABANDONED

Barton

KANSAS

Map No. _____ Sec. 11 Twp. 20 R. 11W

Well No. 12 Kowalsky

Stanolind Company

Contractor

FIRST REPORT

C S L N $\frac{1}{2}$ NE

990 Ft. from N. Line

_____ Ft. from S. Line

1320 Ft. from E. Line

_____ Ft. from W. Line

SILICA POOL

SECTION PLAT

		○	

Location _____

Rig up _____

Drilling and Remarks:

RR

RECORD

Cased _____ in., _____ ft.

Sand _____

Gas _____

Oil _____

Total Depth _____

PRODUCTION

1st 24 hrs. Nat. _____

1st 24 hrs. after shot _____

Gas _____ Cu. Ft.

Dry Hole _____

Abandoned _____

Date

FEB 1 - 1939 19

H. D. Hatfield Scout

Barton **KANSAS**

Map No. 46 Sec. 11 Twp. 20 R. 11W

Well No. 12 Kowalsky

Stanolind

Company

Contractor

COMPLETED

SECTION PLAT

C S L N $\frac{1}{2}$ NE

990 Ft. from N. Line

_____ Ft. from S. Line

1320 Ft. from E. Line

_____ Ft. from W. Line

			0
	S W. D.		

SILICA POOL

RECORD

Location _____

Cased 7 in., 3375 ft.

Rig up _____

Sand Basal 3815

Drilling and Remarks:

Gas _____

Salt water Disposal

Oil _____

Input - 165 wtr

Total Depth 3872

IN 30 min - could

NOT Fill casing

PRODUCTION

1st 24 hrs. Nat. _____

1st 24 hrs. after shot _____

Gas _____ Cu. Ft.

Dry Hole _____

Abandoned _____

Date

MAR 22 1939

19

H. D. Hatfield

Scout