

Barton


**KANSAS**

DX 78-1

Section 30 Township 18 Range 11W

Well No. #1 Bailey

Company Thunderbird Drlg, etal

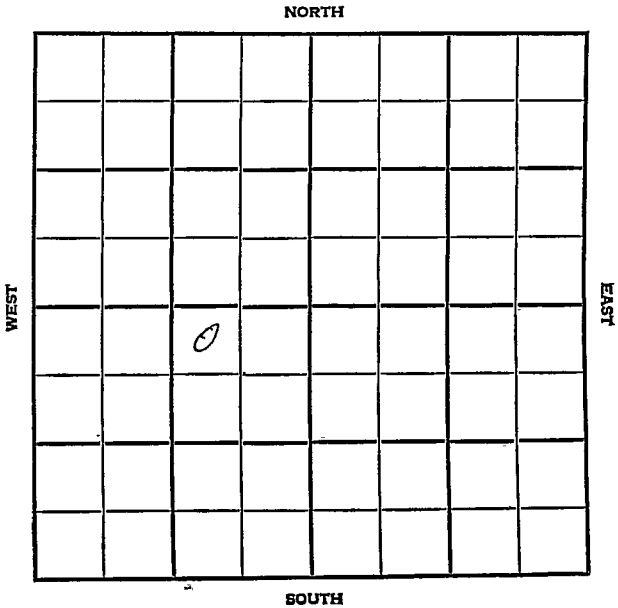



1823 DP  
1826 RB

County Barton Elev. 11W

Sec. 30 Twp. 18 Rge. 11W

Company Thunderbird Drlg. etal

Farm Name Bailey No. 1

TOPS	DEPTH	LOG	DATUM	Loc in Sec.
Anh.	0/0			NW NE SW
TP.				
H.	2979			
Tr.				
Dg.				
Bl.	3092			
L.	3107			
K.C.				Geol.
B.K.C.				Contr.
Ce.				Co. Tools
C.				Pool <u>Bailey</u>
M.				<u>Wildcat</u>
M.				<div style="border: 1px solid black; padding: 5px; display: inline-block;"> <b>COMPLETE</b> </div>
K.				
Mz.				
Me.				
V.				
S.				
S.				
A.	3388			
R.				
PE.				
G.				
TD.	3400			

Date Comm. spd. 10-25-56

8" @ 220 w/125, Drlg. 2396

DST 3110-40 1 hr. 140' oil + gas

240' gas 7P 60-120 BHP not recorded

DST 3137-60 1 hr. 990' oil

7P 95-155 BHP 1100"/20"

DST 3163-83 NOV 7 '56 op. 1 hr. 120'

9554 oil + 45' HOE GCM BHP 1130/20"

DST 3185-3233 1 hr. see 380' HOE GCM

BHP 1120/20" DST 3240-75 op. 20"

Co. No. Sec. No. Sec. No. Sec. No. Sec. No.

G 17" Fluid oil in 18" BHP 1150  
 120" DST 3279-90 1hr 35' Md  
 BHP 140/20 DST 3389-95 1hr  
 rec 10' Md BHP 420 DST 3395  
 -3400 1hr rec 45' HOCM + 10'  
 wtr BHP 1015/20" Rn 9 5 1/2  
 @ 3396 NOV 13 '56 NOV 21 '56 DD 3417  
 S.O. Md & 4 1/2 Bopk no/w  
 POF NOV 28 '56 DEC 5 '56 DEC 12 '56 DEC 19 '56  
 Ph P. 85. Bopd no/w tr  
 grav 39°