

Section 30 Township 18 Range 11 WWell No. # 1 BockCompany Petroleum Inc.

NORTH

							0

SOUTH

WEST

EAST

Barton

KANSAS



30

18

11W

Sec. _____ Twp. _____ R. _____

#1 Bock

Well No. _____ Farm _____

Petroleum, Inc.

Company _____

Petroleum, Inc.

Contractor _____

Wildcat

Ft. from N. Line

330


Ft. from S. Line

330

Ft. from E. Line

Ft. from W. Line

SE SE SE

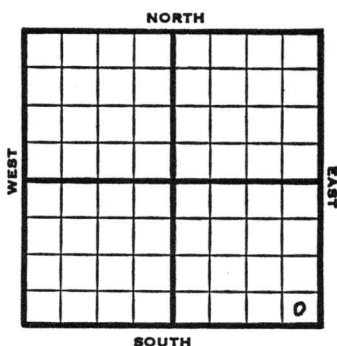

1953 Elev. 1838'

REPORT

5/13

RUR

5/21

8" @ 145

5/27

Spud 5-11-53

D & A

TD 3463'

8" @ 145'

Heeb 3002, Br. time 3114, Lans 3124,

DST 3131-3201 opn 1 hr, rec 40' mud

375# Cong 3428,


DST 3385-3441 opn $\frac{1}{2}$ hr, rec 10' mud

Arb 3458

TD 3463

D & A

ABANDONED

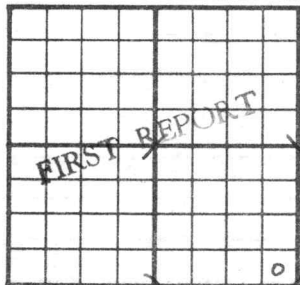County Barton State KansasSec. 30- (Blk.) 18 (Sur.) 11W Map No. (Twp.)Operator Petroleum Inc.Well No. 1 Farm RockElev. Location SE SE SE330 Ft. From S Line SE330 Ft. From E Line Quarter1st. Report MAY 13 1953

Completion


Remarks

Petroleum Inc. - Contr.

Spudding Date

Drlg. Data WildcatR U R

County Barton State Kansas
 Sec. 30 (Blk.) 18 (Sur.) 11W Map No.
 Operator Petroleum Inc.
 Well No. 1 Farm Bock
 Elev. 1838 Location SE SE SE

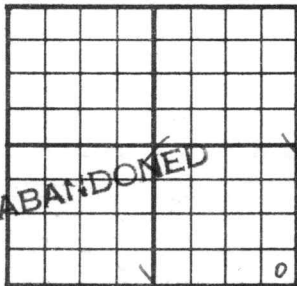

330 Ft. From S Line SE
330 Ft. From E Line Quarter
 1st. Report
 Completion MAY 27 1953
 Remarks Wildcat
Petroleum Inc. - Contr.
 Spudding Date 5-11-53

Drlg. Data D & A TD 3463
8" @ 145 Heeb. 3002 Br. lime 3114
Lans. 3124 DST 3131-3201 open 1 hr.
Rec. 40' mud 375# Cong. 3428
DST 3385-3441 open $\frac{1}{2}$ hr. Rec. 10' mud
Arb. 3458 TD 3463
D & A