


Barton

KANSAS

SECTION 30 TOWNSHIP 18S RANGE 11W

WELL NO. #1 Bock

COMPANY Thunderbird Drlg.

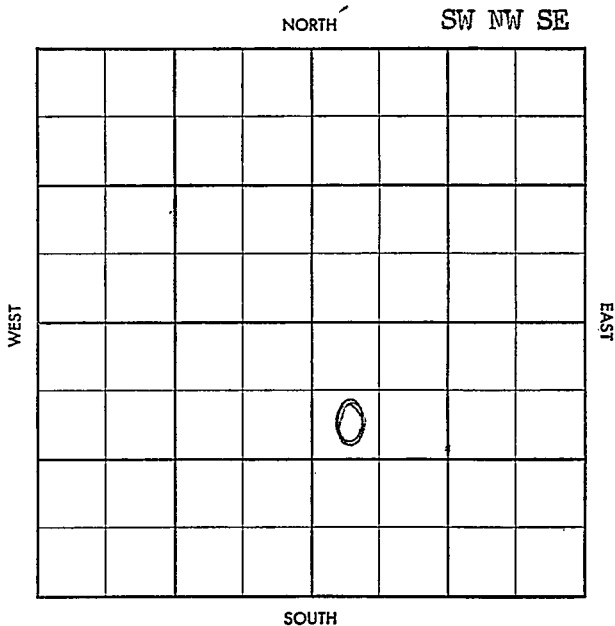

13

S-513-B

County Barton Elev. _____
 Sec. 30 Twp. 18 Rge. 11W
 Company Thunderbird Drlg.
 Farm Name Bock No. 1

TOPS	DEPTH	LOG	DATUM
Anh.			
Tp.			
H.			
Tr.			
Dg.			
B.L.			
L.			
K.C.			
B.K.C.			
Ce.			
C.			
M.			
M.			
K.			
Mz.			
Mq.			
V.			
S.			
S.			
A.			
R.			
Pf.			
G.			
T.D.			

Loc. in Sec. _____
SW NW SE
 Geol. _____
 Contr. _____
Co. Tools
 Pool _____
Bailey

FER 5 58
FIRST REPORT

Date Comm. 2/3/58
8" @ 235, WOC

Co.
Lse.
No.
Sec.
T.
R.

Twp. X Pool X
 Co. X Facet X

8-513-B

County Barton Elev. 1938 OF 1841 RR
 Sec. 30 Twp. 18 Rge. 11W
 Company Thunderbird Drlg.
 Farm Name Bock No. 1

TOPS	DEPTH	LOG	DATUM
Anh.	<u>677</u>		
Tp.			
H.	<u>3001</u>		
Tr.			
Dg.			
B.L.	<u>3111</u>		
L.	<u>3126</u>		
K.C.			
B.K.C.			
Ce.			
C.			
M.			
M.			
K.			
Mz.			
Mq.			
V.			
S.			
S.			
A.	<u>3436</u>		
R.			
Pf.			
G.			
I.D.	<u>3450</u>		

Loc. in Sec. SW NW SE
 Geol. _____
 Contr. _____
 Co. Tools _____
 Pool Bailey

COMPLETE
 MAY 28 '58

Date Comm. 2/3/58
 8" @ 235, WOC FEB 12 '58 DST 3130-60 60"
 240' gap 40' gem BHP 70 DST
 3160 - 90 60" 605' gem FPO-145
 BHP 1062 DST 3190-3212 60"
 150' M&W BHP 905 DST FEB 19 '58
 3260 - 75 60" 40' 140 CM 180
 0.1 BHP 913 DST 3279-96 60"
 20' 0 CM 30' M&W RHP 188
 5" 3448/100 MICT FEB 19 '58 CO 60/3299
 -3314 1500A \$12-13 RHP NW

Co.
 Sec.
 No.
 Sec.
 T.
 R.

1200' 0B

POP

MAR 5 '58

MAR 12 '58

MAR 19 '58

MAR 26 '58

APR 2 '58

APR 9 '58

APR 16 '58

APR 23 '58

APR 30 '58

MAY 7 '58

MAY 14 '58

MAY 21 '58

MAY 28 '58

PhyP 6830pd 18%ow 431g

30-18-11W

sw nw se