
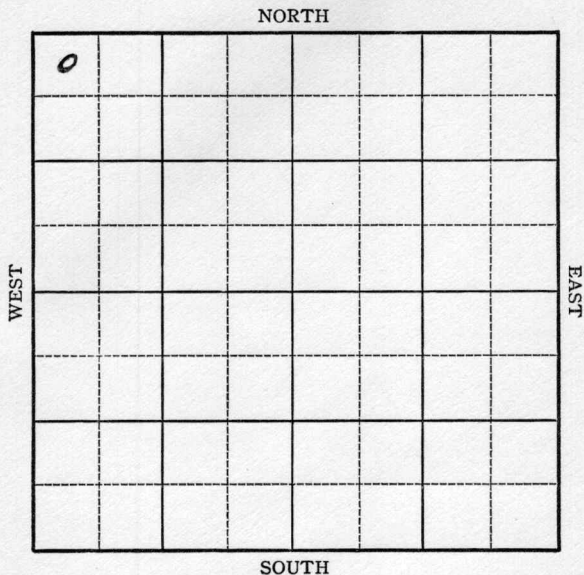


Section 11 Township 20 Range 11-WWell No. #9 Fred PanningCompany Stanolind

Sec. 11 Twp. 20 R. 11-WWell No. #9 Fred Panning FarmStanolind Company330 Ft. from N. Line Ft. from S. Line Ft. from E. Line330 Ft. from W. Line

Elev. 1761

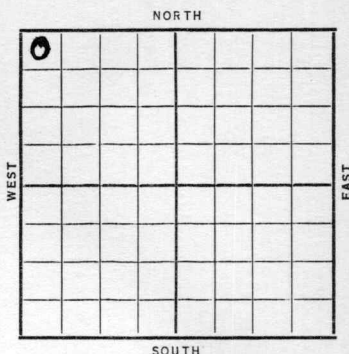

Date	REPORT
1937	
10/20	B.R.R.
10/21	10" @ 221'. WOC.
11/5	Drlg. 2894'.
11/12	Sil. & 6" @ 3281'. T.D. 3285'.
	RUST. No shows.
11/19	T.D. 3300'. 2500' oil.
	Swab 10 bbls. oil P.H. Nat.
	2000 acid. Swabbing 22 bbls. oil.
	P.H.
11/23	6" @ 3281'.
	Sil. 3281'.
	T.D. 3300'.
	5000 acid.
	Potential 1363 bbls.
	COMPLETED

Barton KANSAS

Map No. _____ Sec. 11 Twp. 20 R. 11WWell No. 9 Fred Panning_____ Stanolind _____ Company

_____ Contractor

FIRST REPORT

NW/C

330 Ft. from N. Line

_____ Ft. from S. Line

330 Ft. from E. Line330 Ft. from W. Line

SECTION PLAT

①			

Location _____

Rig up _____

Drilling and Remarks:

BRR

RECORD

Cased _____ in., _____ ft.

Sand _____

Gas _____

Oil _____

Total Depth _____

PRODUCTION

1st 24 hrs. Nat. _____

1st 24 hrs. after shot _____

Gas _____ Cu. Ft.

Dry Hole _____

Abandoned _____

Date

OCT 20 1937 19H. D. Hatfield Scout

Barton KANSAS

Map No. 46 Sec. 11 Twp. 20 R. 11WWell No. 9 Fred PanningStanolind

Company

Contractor

COMPLETED
NW/C

SECTION PLAT

0			

330 Ft. from N. Line

_____ Ft. from S. Line

_____ Ft. from E. Line

330 Ft. from W. Line

Location _____

Rig up _____

Drilling and Remarks:

5000 acidPOT-1363

RECORD

Cased 6 in., 3281 ft.Sand 511 3281

Gas _____

Oil _____

Total Depth 3300

PRODUCTION

1st 24 hrs. Nat. _____

1st 24 hrs. after shot _____

Gas _____ Cu. Ft.

Dry Hole _____

Abandoned _____

Date

NOV 23 1937 19 H. D. Hatfield Scout