

KANSAS

Form 51—5M—7-39—Palace


Barton

Section 11 Township 20 Range 11-W

Well No. #7 State

Company Derby

NORTH Silica Pool

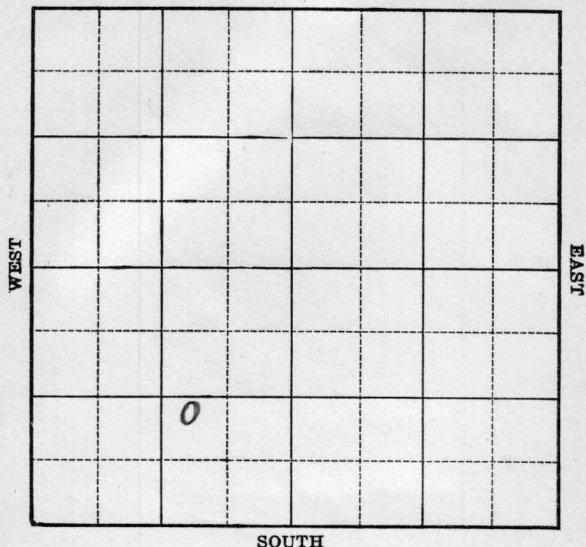


KANSAS

Barton

Sec. 11 Twp. 20 R. 11-WWell No. #7 State FarmDerby

Company

(Silica)

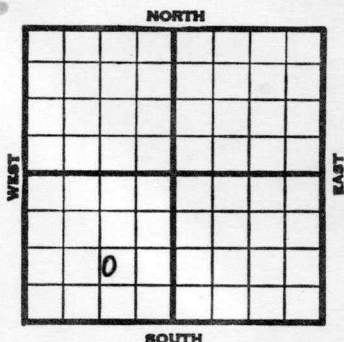 Ft. from N. Line960 Ft. from S. Line1170 Ft. from E. Line Ft. from W. Line

Elev. 1757

REPORT

1940

3/13

Location

3/21

Derrick.

3/28

7" - 248' Drlg. 2305'

4/4

Arb. 3275-77' T.D. 4" - 3276'

RUST.

4/12

T.D. 3287½' Swab 30 bbls. oil
per hour. tubing.

4/18

" " "

4/25

" " "

5/1

Arb. 3275'

4" - 3276'

T.D. 3287½'

Depthograph potential 1043 bbls.

COMPLETED

Barton KANSAS

Map No. 46 Sec. 11 Twp. 20 R. 11WWell No. 7 StateDerby

Company

Contractor

FIRST REPORT

SECTION PLAT

NW SE SW

Ft. from N. Line

960 Ft. from S. Line1170 Ft. from E. Line

Ft. from W. Line

SILICA POOL

	o		

Location X

Rig up

Drilling and Remarks:

RECORD

Cased _____ in., _____ ft.

Sand _____

Gas _____

Oil _____

Total Depth _____

PRODUCTION

1st 24 hrs. Nat. _____

1st 24 hrs. after shot _____

Gas _____ Cu. Ft.

Dry Hole _____

Abandoned _____

Date

MAR 13 1940

19

S. J. LEWIS

Scout

Map No. 46 Sec. 11 Twp. 20 R. 11WWell No. 7 State

Derby

Company

Contractor

COMPLETED

SECTION PLAT

NW SE SW

Ft. from N. Line

960

Ft. from S. Line

1170

Ft. from E. Line

Ft. from W. Line

SILICA POOL

	△		

Location

Rig up

Drilling and Remarks:

*at 3275**4" @ 3276**Depth graph 16 P & T*
1043

RECORD

Cased _____ in., _____ ft.

Sand _____

Gas _____

Oil _____

Total Depth 3287 1/2

PRODUCTION

1st 24 hrs. Nat. _____

1st 24 hrs. after shot _____

Gas _____ Cu. Ft.

Dry Hole _____

Abandoned _____

Date

MAY 1

1940

19

S. J. LEWIS

Scout