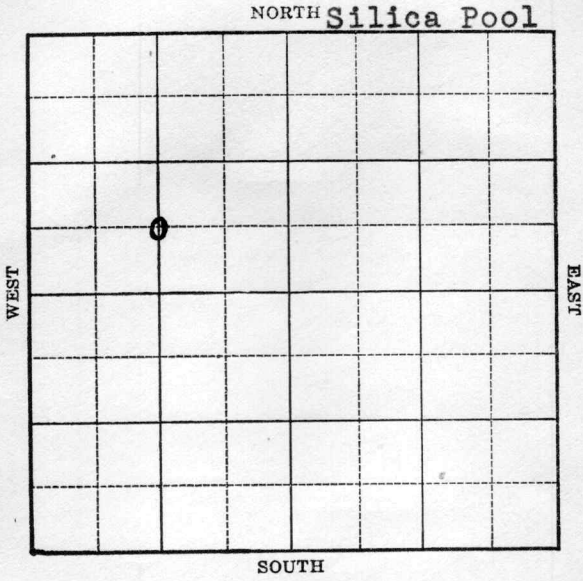


Section 11 Township 20 Range 11-WWell No. 19 Fred PanningCompany Stanolind

KANSAS


Barton

Sec. 11 Twp. 20 R. 11-WWell No. #19 Fred Panning FarmStanolind Company

(Silica)

 Ft. from N. Line660 Ft. from S. Line Ft. from E. Line1320 Ft. from W. Line

Elev. 1758

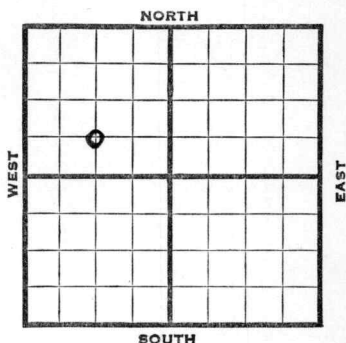

1939	REPORT
4/12	R.U.R.
4/21	10" - 206' Anhy 490' Drlg. 1465'
4/28	Drlg. 3207'
5/5	Arb. 3273' 7" - 3273' T.D. 3275' 1000' oil 1½ hrs. Cored to 3280½' T.D. swab 42 bbls. off bottom per hour. 1000 acid. Swab 82 bbls. 8½ hours.
5/10	Arb. 3273' T.D. 3280½' 7" - 3273' 1000 acid. Pump 609 bbls. in 8 hours. Potential 1828 bbls.
	COMPLETED

Barton

KANSAS

Map No. 46 Sec. 11 Twp. 20 R. 11WWell No. 19 Fred PanningStanolind

Company

Contractor

FIRST REPORT

C S $\frac{1}{2}$ NW Ft. from N. Line660 Ft. from S. Line Ft. from E. Line1320 Ft. from W. Line

SILICA POOL

SECTION PLAT

Location Rig up

Drilling and Remarks:

RUR

RECORD

Cased in., ft.Sand Gas Oil Total Depth

PRODUCTION

1st 24 hrs. Nat. 1st 24 hrs. after shot Gas Cu. Ft.Dry Hole Abandoned

Date

APR 12 1939

19

H. D. Hatfield Scout

Barton

KANSAS

Map No. 46 Sec. 11 Twp. 20 R. 11WWell No. 19 Fred ParmingStanolind

Company

Contractor

COMPLETED

SECTION PLAT

C S $\frac{1}{2}$ NW

Ft. from N. Line

660 Ft. from S. Line

Ft. from E. Line

1320 Ft. from W. Line

SILICA POOL

Location _____

Rig up _____

Drilling and Remarks:

*Cr 4.3273**7" @ 3273**1000 acid**Pump 609 in 8 hrs**Po 4.1828*

RECORD

Cased _____ in., _____ ft.

Sand _____

Gas _____

Oil _____

Total Depth 3280 1/2

PRODUCTION

1st 24 hrs. Nat. _____

1st 24 hrs. after shot _____

Gas _____ Cu. Ft.

Dry Hole _____

Abandoned _____

Date

MAY 10 1939 19

S. J. LEWIS Scout