

KANSAS


Form 51—5M—7-39—Palace

Barton

Section 11 Township 20 Range 11-W

Well No. #6 State

Company Derby

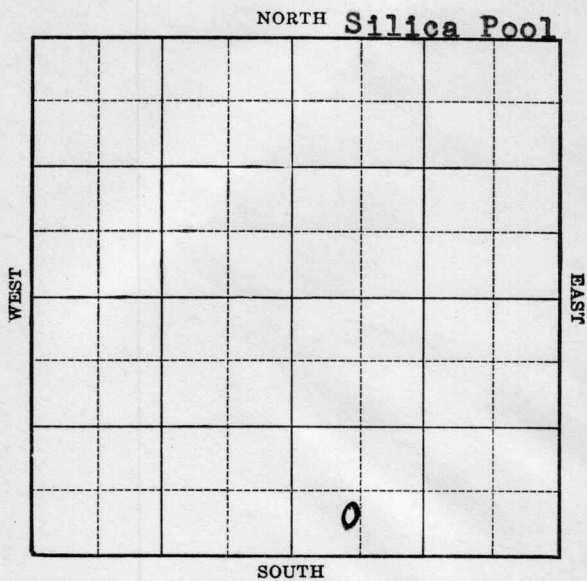

KANSAS

Barton

Sec. 11 Twp. 20 R. 11-W

Well No. #6 State Farm

Derby _____ Company


(Silica)

Ft. from N. Line

470 Ft. from S. Line

Ft. from E. Line

630 Ft. from W. Line

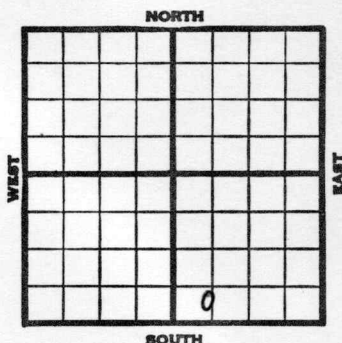

Elev. 1754

[illegible]

Barton

KANSAS

Map No. 46 Sec. 11 Twp. 20 R. 11WWell No. 6 State

Derby

Company

FIRST REPORT

Contractor

Approx.

C S L SW SE

SECTION PLAT

Ft. from N. Line

470 Ft. from S. Line

Ft. from E. Line

630 Ft. from W. Line

SILICA POOL

Location

RECORD

Cased _____ in., _____ ft.

Sand _____

Gas _____

Oil _____

Total Depth _____

PRODUCTION

1st 24 hrs. Nat. _____

1st 24 hrs. after shot _____

Gas _____ Cu. Ft.

Dry Hole _____

Abandoned _____

Drilling and Remarks:

Moving in Roty.

Date

MAR 6 1940 19

S. J. LEWIS

Scout

Barton

Map No. 46 Sec. 11 Twp. 20 R. 11WWell No. 6 State

Derby

Company

COMPLETED

Contractor

Approx.

C. S L SW SE

SECTION PLAT

_____ Ft. from N. Line

470 Ft. from S. Line

_____ Ft. from E. Line

630 Ft. from W. Line

SILICA POOL

Location _____

Rig up _____

Drilling and Remarks:

*Cor. 8. 3282**4" @ 3282.**4000 acid**Depthograph 1182.*

RECORD

Cased _____ in., _____ ft.

Sand _____

Gas _____

Oil _____

Total Depth 3292.

PRODUCTION

1st 24 hrs. Nat. _____

1st 24 hrs. after shot _____

Gas _____ Cu. Ft.

Dry Hole _____

Abandoned _____

Date

APR 17 1940 19

S. J. LEWIS Scout