


Section 11 Township 20 Range 11-W

Well No. #9 Stueckmann (Stueckmann)

Company Stanolind

NORTH Silica Pool

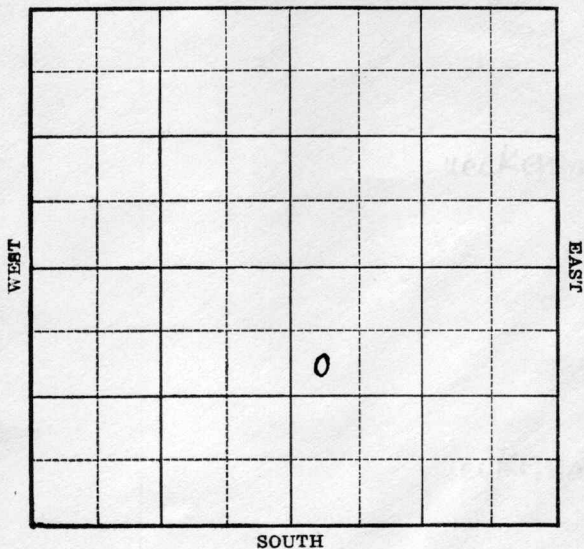

KANSAS

Barton

Sec. 11 Twp. 20 R. 11-W

Well No. #9 Stueckmann Farm

Stanolind Company

(Silica)


990 Ft. from N. Line

_____ Ft. from S. Line

_____ Ft. from E. Line

330 Ft. from W. Line

Elev. 1756

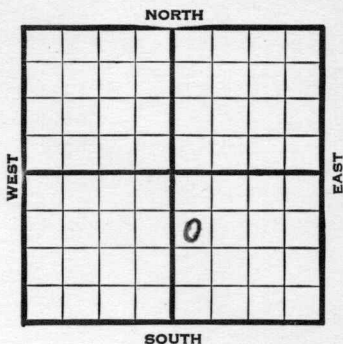

1939	REPORT
8/2	Location
8/10	8" - 219' Drlg. 250'
8/17	Anhy 490' Drlg. 3110'
8/24	Arb. 3285' 5" - 3286'
	T.D. 3290' SD.
8/31	" " "
9/7	Arb. 3285' 5" - 3286'
	T.D. 3290' RUST.
9/13	Arb. 3285'
	5" - 3286'
	T.D. 3291'
	1000 acid.
	Depthograph potential 1663 bbls.
	COMPLETED

Barton KANSAS

Map No. _____ Sec. 11 Twp. 20 R. 11W

Well No. 9 Stueckmann

Stanolind Company

Contractor

FIRST REPORT

SECTION PLAT

SW NW SE

990 Ft. from N. Line

_____ Ft. from S. Line

_____ Ft. from E. Line

330 Ft. from W. Line

		o	

SILICA POOL

Location X

Rig up _____

Drilling and Remarks:

RECORD

Cased _____ in., _____ ft.

Sand _____

Gas _____

Oil _____

Total Depth _____

PRODUCTION

1st 24 hrs. Nat. _____

1st 24 hrs. after shot _____

Gas _____ Cu. Ft.

Dry Hole _____

Abandoned _____

Date

AUG 2 1939

19

S. J. LEWIS

Scout

Map No. _____ Sec. 11 Twp. 20 R. 11W

Well No. 9 Stueckmann

Stanolind Company

Contractor

COMPLETED

SW NW SE

990 Ft. from N. Line

_____ Ft. from S. Line

_____ Ft. from E. Line

330 Ft. from W. Line

SECTION PLAT

SILICA POOL

Location _____

Rig up _____

Drilling and Remarks:

Ar 8285

5" @ 8286

1000 acid

*Depthograph Pad
1663*

RECORD

Cased _____ in., _____ ft.

Sand _____

Gas _____

Oil _____

Total Depth 3291

PRODUCTION

1st 24 hrs. Nat. _____

1st 24 hrs. after shot _____

Gas _____ Cu. Ft.

Dry Hole _____

Abandoned _____

Date

SEP 13 1939

19

S. J. LEWIS

Scout