



Map No. **KANSAS** Sec. 31 Twp. 18 R. 11W

Well No. 1 Kimpler Farm  
W & Sharon Company


**TORREY & FEASTER**

990 Ft. from N. Line

\_\_\_\_\_ Ft. from S. Line

330 Ft. from E. Line

\_\_\_\_\_ Ft. from W. Line

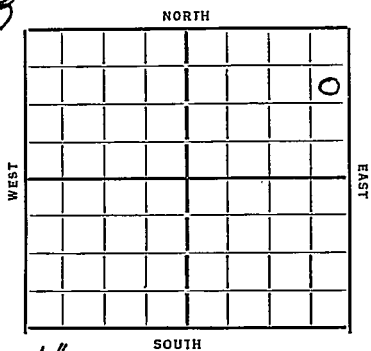

"Special"

Date	REPORT	O. W. D. D
3/14	Moving in	
3/22	Cellar	
3/29	Material	
4/5	— 4/12 —	
4/19	Bldg Rig	
4/26	Rig	
5/3	Spud	
5/10	blg 240	
5/18	— 5/25 —	
5/21	SD 240	
6/7	— 6/14 — 6/21 — 6/28 —	
7/5	— 7/12 — 7/19 — 7/26 —	
8/2	— 8/9 — 8/16 — 8/23 —	
8/30	— 9/6 — 9/13 — 9/20 —	
9/27	— 10/4 — 10/11 — 10/18 —	
10/25	— 11/1 — 11/8 — 11/15 —	
11/22	— 11/28 — 12/6 — 12/13 —	
12/21	— 12/27 — 1/3/35 — 1/10 —	
1/17	— 1/24 — 1/31 — 2/7 —	
2/14	— 2/21 — 2/28 — 3/7 —	
3/14	— 3/21 — 3/28 — 4/4 —	
4/11	— 4/18 — 4/26 — (over) 5/2 — 5/9 —	

5/15 T 7 240  
Abk loc.

ABANDONED

1935 O.W.D.D

8/14 15" 255 12" 305  
dly 405

8/22 dly 1030 12" 674

8/29 " 1700

9/6 57 1800.

10/3 — 10/10 — 11/1 — 11/7 — 11/14 —

11/21 —

11/29 TD 1815 Co to 1795  
Cm 10"

12/6 10" 1919  
dly 2010

12/13 SD 2075 TD 2200  
SD for water

12/19 dly 2355

12/26 dly 2580 8" 2536

1/2/36 " 2725

OVER

1/10/36 Top Topoka 2728  
Sho wto 2885  
6" 2943 TD 2975 C.O.

1/17 Top Lams. 3120  
Dly 3210

1/23 Top Silicious 3424  
TD 3426  
150 feet Oil in hole  
C.O.  
Will drill deeper (2d)

1/24 Top Silicious 3424  
at 3426 had 150 feet  
oil in hole  
TD 3441  
w R 5" (2d)

1/28 Top Sil 3424  
Filled up 150' Oil at 3426  
Ran 4" liner to 3426 where  
they had sho oil  
Drilled to TD 3441  
liner dropped down hole  
pulled liner out  
Hole filled up 1200' Oil  
Have 30 feet savings in hole  
Will run 5" down to Top Sil  
& C.O. (2d) OVER

- 2/5 - 5" 3415  
CO to lower pipe (2el)
- 2/7 6" 3416 Swabbing
- 2/10 CO 3 feet off Btm  
Will lower 5" to top of  
Silicious  
1000 feet Oil in hole (2el)
- 2/12 Set 5" 3426  
Railed down  
Filled up 1 barrel Oil per hr  
Drilled to TD 3468  
No Sulphur water  
20 PB to 3460 & acidize (2el)
- 2/21 PB 3462  
1000 acid No help S.D.
- 2/28 —
- 3/6 6" 3417 Slg plug.
- 3/11 Oil 3424  
TD 3468 PB 3462  
No water  
1000 acid No help  
40 gts

D. A.

COMPLETED

Map No. 55 Sec. 31 Twp. 18 R. 11W

Well No. 1-Kimblev

Mr. A. Shearon Company

Contractor

**FIRST REPORTS**

**SECTION PLAT**

990 Ft. from N. Line

..... Ft. from S. Line

330 Ft. from E. Line

..... Ft. from W. Line

			⊙

**SPECIAL**

**SPECIAL**

Location.....

Rig up.....

Drilling and Remarks:

*moving in*

**RECORD**

Cased..... in., ..... ft.

Sand.....

Gas.....

Oil.....

Total Depth.....

**PRODUCTION**

1st 24 hrs. Nat.....

1st 24 hrs. after shot.....

Gas..... Cu. Ft.

Dry Hole.....

Abandoned.....

Date

3-14-34 1934

O. Manschick Scout

Map No. 55 Sec. 31 Twp. 18 R. 11W

Well No. 1-Kimpler

W. G. Shearon Company

Contractor

**ABANDONED**

**SECTION PLAT**

990 Ft. from N. Line

..... Ft. from S. Line

330 Ft. from E. Line

..... Ft. from W. Line

			0

**RECORD**

Location.....

Cased..... in., ..... ft.

Rig up.....

Sand.....

Drilling and Remarks:

Gas.....

Oil.....

Total Depth 240

*add for*

**PRODUCTION**

1st 24 hrs. Nat.....

1st 24 hrs. after shot.....

Gas..... Cu. Ft.

Dry Hole.....

Abandoned.....

Date

**ORVAL MANNSCHECK**

5-15-35 192.....

Scout

*Barton*  
Map No. *55* Sec. *31* Twp. *18* R. *11W*

Well No. *1-Kimpler*  
*Tarrey & Heaster* Company

Contractor

~~FIRST REPORT~~

SECTION PLAT

*990* Ft. from N. Line  
Ft. from S. Line  
*330* Ft. from E. Line  
Ft. from W. Line

			<i>0</i>

FIRST REPORT

*Awdd*

Location

Rig up

Drilling and Remarks:

*15" 255*  
*12" 305*  
*2 1/2" 405*

RECORD

Cased in ft.  
Sand **CORRECTION**  
Gas *Co. Names*  
Oil  
Total Depth

PRODUCTION

1st 24 hrs. Nat.  
1st 24 hrs. after shot  
Gas Cu. Ft.  
Dry Hole  
Abandoned

Date

*8-14-35*

192 *ORVAL MANNSCHRECK* Scout

Map No. 35 Sec. 31 Twp. 18 R. 11W

Well No. 1-Kimpler

Torrey + Feaster Company

ABANDONED Contractor

SECTION PLAT

Special  
996 Ft. from N. Line

..... Ft. from S. Line

330 Ft. from E. Line

..... Ft. from W. Line

			0

o.w.d.d

Location.....

Rig up.....

Drilling and Remarks:

P.B. 3462  
S.O. + water  
1000 acid no  
help.  
40 gts  
10 + FF

RECORD

Cased..... in., ..... ft.

Sand Sil 3424

Gas.....

Oil.....

Total Depth 3468

PRODUCTION

1st 24 hrs. Nat.....

1st 24 hrs. after shot.....

Gas..... Cu. Ft.

Dry Hole.....

Abandoned.....

Date

3-11-36 192.....

ORVAL MANNSCHRECK

Scout