

Barton


KANSAS

FORM 51 5M 2-38 TPCO.

Section 11 Township 20 Range 11-W

Well No. 5 Stukeman (Stueckemann)

Company Stanolind

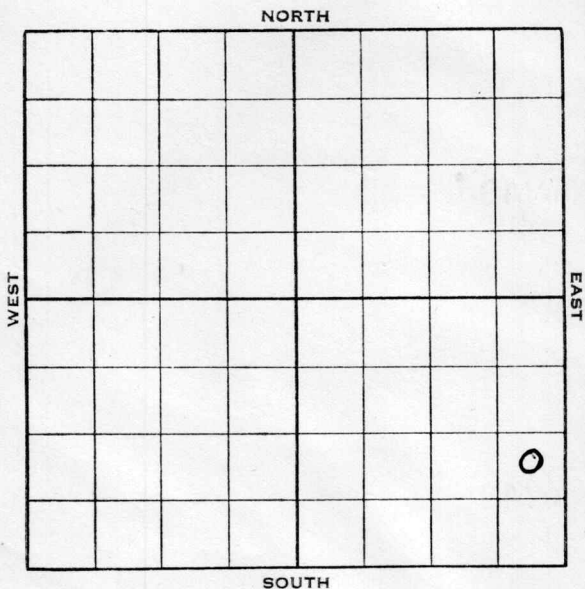

Sec. 11 Twp. 20 R. 11-W

Well No. #5 Stukeman Farm


Stanolind Company

\_\_\_\_\_ Ft. from N. Line

990 Ft. from S. Line

380 Ft. from E. Line

\_\_\_\_\_ Ft. from W. Line

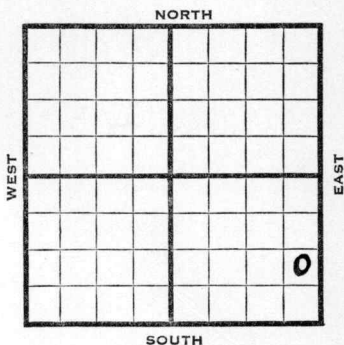

Elev. 1754

1938	REPORT
8/24	R. R.
9/2	10" - 222'. WOC.
9/9	Anh. 470'. Dlg. 2298'.
9/16	Arb. 3270-77' T.D. S. O. 7" - 3271'. RUST.
9/23	T.D. 3281'. 1800' oil. 2000 acid. Swab 42 oil per hr. 3000 acid.
9/28	7" at 3271'. Arb. 3270'. T. D. 3381'. 3000 acid. Pump 278 bbls. 4 hrs. & 268 bbls. 4 hours. Potential 1668 bbls.
	COMPLETED

Barton KANSAS

Map No. 46 Sec. 11 Twp. 20 R. 11W

Well No. 5 Stukeman

Stanolind Company

Contractor

FIRST REPORT

SECTION PLAT

NE SE SE

			0

\_\_\_\_\_ Ft. from N. Line

990 Ft. from S. Line

380 Ft. from E. Line

\_\_\_\_\_ Ft. from W. Line

Location \_\_\_\_\_

Rig up \_\_\_\_\_

Drilling and Remarks:

**RR**

RECORD

Cased \_\_\_\_\_ in., \_\_\_\_\_ ft.

Sand \_\_\_\_\_

Gas \_\_\_\_\_

Oil \_\_\_\_\_

Total Depth \_\_\_\_\_

PRODUCTION

1st 24 hrs. Nat. \_\_\_\_\_

1st 24 hrs. after shot \_\_\_\_\_

Gas \_\_\_\_\_ Cu. Ft.

Dry Hole \_\_\_\_\_

Abandoned \_\_\_\_\_

Date

AUG 24 1938

19

H. D. Hatfield

Scout

Barton KANSAS

Map No. 46 Sec. 11 Twp. 20 R. 11W

Well No. 5 Stukeman

Stanolind Company

Contractor

**COMPLETED**

NE SE SE

990 Ft. from N. Line

990 Ft. from S. Line

380 Ft. from E. Line

         Ft. from W. Line

**SECTION PLAT**

			o

Location                                 

Rig up                                 

Drilling and Remarks:

*3000 acid*

*P- 278/4 x 268/4*

*POT 1668*

**RECORD**

Cased 7 in., 3271 ft.

Sand ARB 3270

Gas                                 

Oil                                 

Total Depth 3381

**PRODUCTION**

1st 24 hrs. Nat.                                 

1st 24 hrs. after shot                                 

Gas                                  Cu. Ft.

Dry Hole                                 

Abandoned                                 

Date

SEP 28 1938 19

H. D. Hatfield Scout