


Barton

KANSAS

Section 11 Township 20 Range 11-W

Well No. #6 Stukeman (Stuekemann)

Company Stanolind

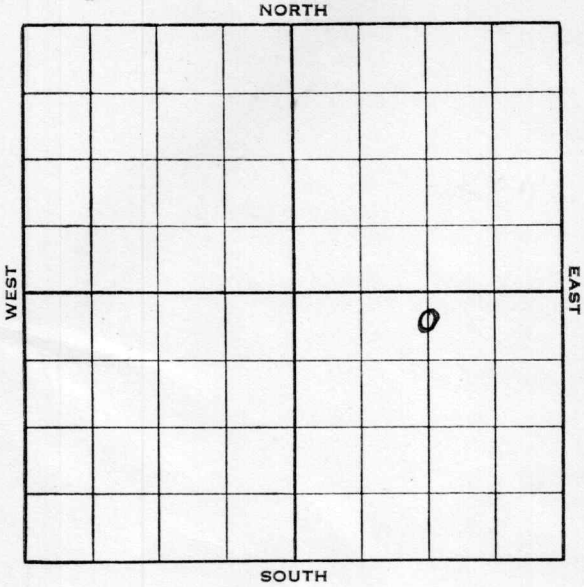

KANSAS

Barton

Sec. 11 Twp. 20 R. 11-W

Well No. #6 Stukeman Farm

Stanolind _____ Company


330 Ft. from N. Line

_____ Ft. from S. Line

1320 Ft. from E. Line

Ft. from W. Line

Elev. 1760'.

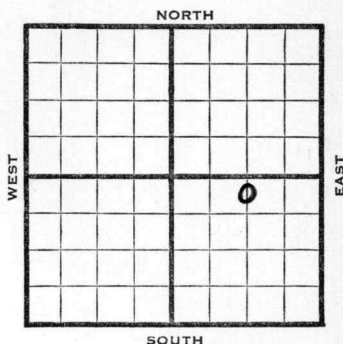

1938

REPORT

9 / 28

Location

10/7

10" - 210'

WOC.

10/14

Dlg. 2177'.

10/21

Arb. 3272-75'.

10/28

7" - 3273'. T.D. 3284'.

5000 acid.

11/2

7" - 3273'.

Arb. 3272'.

T. D. 3284'.

5000 acid.

Potential 2145 bbls.

COMPLETED

Barton KANSAS

Map No. 46 Sec. 11 Twp. 20 R. 11WWell No. 6 StukemanStanolind Company

Contractor

FIRST REPORT

C N L SE

330 Ft. from N. Line Ft. from S. Line1320 Ft. from E. Line Ft. from W. Line

SECTION PLAT

Location XRig up

Drilling and Remarks:

RECORD

Cased in., ft.Sand Gas Oil Total Depth

PRODUCTION

1st 24 hrs. Nat. 1st 24 hrs. after shot Gas Cu. Ft.Dry Hole Abandoned

Date

SEP 28 1938 19 H. D. Hatfield Scout

Map No. 46 Sec. 11 Twp. 20 R. 11WWell No. 6 StukemanStanolind

Company

Contractor

COMPLETED

SECTION PLAT

		0	

330 C N L SE
Ft. from N. Line

Ft. from S. Line

1320 Ft. from E. Line

Ft. from W. Line

Location

Rig up

Drilling and Remarks:

5000 AcidPOT 2145

RECORD

Cased 7 in., 3273 ft.Sand 4-6 3272

Gas

Oil

Total Depth 3284

PRODUCTION

1st 24 hrs. Nat.

1st 24 hrs. after shot

Gas Cu. Ft.

Dry Hole

Abandoned

Date

NOV 2 - 1938

19

H. D. Hatfield Scout