


Map No. KANSAS Sec. 12 Twp. 20 R. 11^w

Well No. 1-Berscheidt Farm
Jorey et al Company

 Ft. from N. Line
940 Ft. from S. Line
990 Ft. from E. Line
 Ft. from W. Line

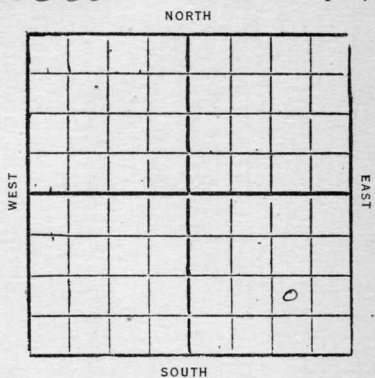

1932

Date	REPORT
8/17	Mushy pond
8/24	
8/31	Reg & tools
9/7	clean up
9/14	Drlog
9/21	Drlog 260
9/30	" 20"-20"
	15 1/2"-105"
	12 1/2"-461
	Drlog 870'
10/5	" 1535'
10/12	10"-1683
	Drlog 1910'
10/19	T.D. 2045 Run 8"
10/26	Drlog 2360'
10/	
11/2	VIR 8" to 2400' T.D.
11/9	8" hanging 2400'
	T.D. 2670' Prsg
11/16	set 8"-2630
	Drlog 2940'
	(over)

11/23- Top K.C. lime 3027
shaw oil 3065
drlg 3125'

11/30- Top Chic 3293
drlg 3317
no oil or water

12/7- Top Chic lime 3293
HFW 3328-33.
TD 3333
Abandoned

Barton

46 KANSAS

Map No. Sec. 17 Twp. 20 R. 11 W

Well No. 1 Berscheid

Torey et al

Company

Contractor

FIRST REPORTS

SECTION PLAT

Ft. from N. Line

990 Ft. from S. Line

990 Ft. from E. Line

Ft. from W. Line

Location

Rig up

Drilling and Remarks:

Blush Pond

F

RECORD

Cased in, ft.

Sand

Gas

Oil

Total Depth

PRODUCTION

1st 24 hrs. Nat.

1st 24 hrs. after shot

Gas Cu. Ft.

Dry Hole

Abandoned

Date

AUG 17 1932

CHAS. L. SHERWOOD

192

Scout

46

KANSAS

Barton

W

Map No. Sec. 12 Twp. 20 R. 11

Well No. 1 Ber Scheider

Terey et al Company

Contractor

SECTION PLAT

COMPLETED

..... Ft. from N. Line

990 Ft. from S. Line

990 Ft. from E. Line

..... Ft. from W. Line

			0

ABANDONED

Location.....

Rig up.....

Drilling and Remarks:

Top Siliceous 3293

HF W 3328.33

RECORD

Cased.....in.,ft.

Sand.....

Gas.....

Oil.....

Total Depth 3333

PRODUCTION

1st 24 hrs. Nat.....

1st 24 hrs. after shot.....

Gas.....Cu. Ft.

Dry Hole..... ✓

Abandoned..... ✓

Date

DEC 7 1932

CHAS. L. SHERWOOD

192.....

Scout