


SECTION 30 TOWNSHIP 18S RANGE 11W

WELL NO. #1 Robl

COMPANY Glickman Oil Co.

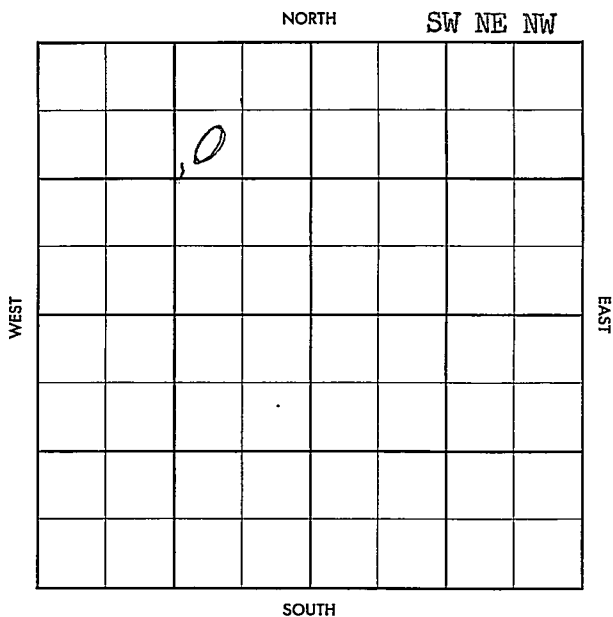

B

County Barton

Elev. _____

Sec. 30 Twp. 18S

Rge. 11W

Company Glickman Oil Co.

Farm Name Robl

No. 1

Co.

Lse.

No.

Sec.

T.

R.

TOPS	DEPTH	LOG	DATUM
Anh.			
Tr.			
H.			
Tr.			
Dg.			
Bl.			
L.			
K.C.			
B.K.C.			
Ce.			
C.			
M.			
M.			
K.			
Mz.			
Me.			
V.			
S.			
S.			
A.			
R.			
Pe.			
G.			
T.D.			

Loc. in Sec. SW NE NW

Geol. _____

Contr. _____

Thunderbird

Tools
Pool

Bailey

<p>FIRST REPORT</p> <p>SEP 14 1957</p>			

Date Comm. _____

MIRT

Co.

County Barton Elev. 1818 KB
 Sec. 30 Twp. 18S Rgs. 11W
 Company Glickman Oil Co.
 Farm Name Robl No. 1

TOPS	DEPTH	LOG	DATUM
Anh.			
Tp.			
H.	2986		
Tr.			
Dg.			
Bl.	3099		
L.	3113		
K.C.			
B.K.C.	3363		
Ce.			
C.	3402		
M.			
M.			
K.			
Mz.			
Me.			
V.			
S.			
S.			
A.			
R.			
PE.			
G.			
TD.	3450		

Loc. in Sec. SW NE NW
 Geol. _____
 Contr. _____
Thunderbird
 Tools _____
 Pool _____
Bailey

ABANDONED		
		SEP 25 57

Lse.

No.

Sec.

T.

R.

Date Comm. MIRT SEP 18 57 9-10-57
18 3260 SEP 22 57

DBA