

Barton

KANSAS

30

18


11

W

SECTION _____ TOWNSHIP _____ RANGE _____

WELL NO. #1 Rohl

COMPANY Thunderbird Drlg.

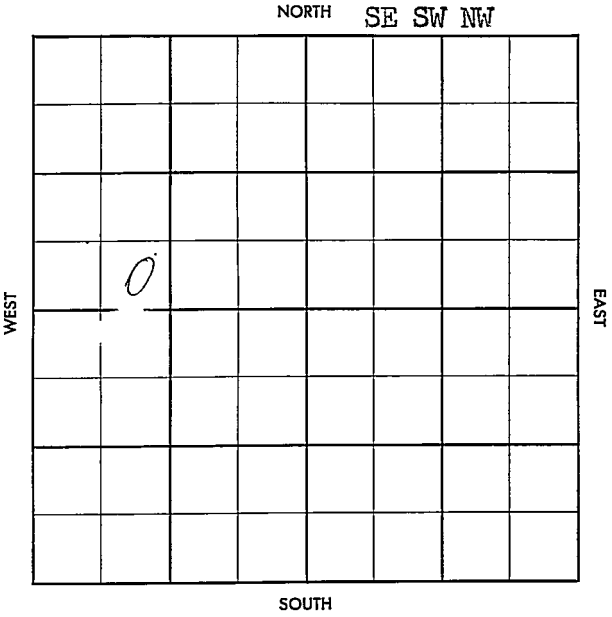

County Barton Elev. _____
 Sec. 30 Twp. 18 Rge. 11
 Company Thunderbird Drig.
 Farm Name Robl No. 1

TOPS	DEPTH	LOG	DATUM	Loc. in Sec.
Anh.				SE SW NW
Tp.				
H.				
Tr.				
Dg.				
BL.				
L.				Geol. _____
K.C.				Contr. _____
B.K.C.				
Ce.				Co. Tools
C.				
M.				Pool
M.				Bailey
K.				
Mz.				
Mo.				
V.				
S.				FIRST REPORT
S.				of
A.				
R.				
PE.				
G.				MAR 27 57
T.D.				

Date Comm. 3-23-57
8" @ 244/145. WOC

~~3~~

Co.
 Loc.
 No.
 Sec.
 T.
 R.

County	Barton	Elev.	1810
Sec.	30	Twp.	18
Company	Thunderbird Drilling		
Farm Name	Robl	No.	1

TOPS	DEPTH	LOG	DATUM	Loc. in Sec.
Anh.				SE SW 1/4
Tr.				
Dg.				
Bl.	2968			
L.	3081			
K.C.	3096			Geol.
B.K.C.				Contr.
Ce.				Co. Tools
C.				Pool
M.				Bailey
M.				
K.				
Mz.				
Mo.				
V.				
S.				
A.	3383			COMPLETE
R.				
PE.				
G.				
T.D.	3459			JUL 3 '57

Date Comm. 3-23-57

8" @ 244/145, WOC DST 2911

-20 lhr 35' M&W BHP 1050

DST 3098-3126 lhr 120'50"

GCM BHP 635'30 DST 3138-70

70" @ 8" rec 1548' oil +

800' GCO BHP 1070/30" DST

3229-45 lhr 6.7" rec 1688'

oil BHP 1115'35" DST 3385-93

40" @ 57' @ 40" rec 15' Md

BHP 922 5 1/2 3459 WOCT

APR 7 '57

CO 12 13480-02

18/3405-08 B 4 Goph

no/w 1 1/2 \$ 100% WTW

1600' O.B. 509 PF. APR 24 '57

REF 8, 3400-02 12, 3405-08

1 1/2 \$ 1/2 BO + 11 BWPS

PB 3289 20 3270-75

B 1 Goph no/w 3.9 F.S.W

13 Boph no/w thru esg

MAY 1 '57 X Rigged to F.S.W W.O.

ST tst. MAY 15 '57 MAY 15 '57 MAY 15 '57

JUN 5 '57 JUN 5 '57 JUN 5 '57 JUN 5 '57

Ph F. 214 BO no/w

graw 40.9°