

Barton

KANSAS

SECTION 31 TOWNSHIP 18 RANGE 11 W

WELL NO. #1 Kimpler "C"

COMPANY Thunderbird

NORTH

						0	

WEST

EAST

SOUTH

SEC.	TWP.	R..
31-	18	11W

WELL NO.

#1 Kimpler "C"

FARM

COMPANY

Thunderbird

CONTRACTOR

Co. Tools


_____ Ft. from N. Line

_____ Ft. from S. Line

_____ Ft. from E. Line

_____ Ft. from W. Line

SW NE NE

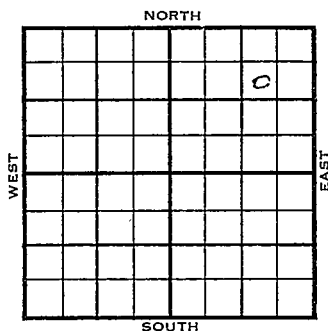

1955

ELEVATION
1828'

REPORT

12-7

Comm. 12-3-55
8" @ 183/135
Drlg. 2123'

1956

1-11

DST 3114-45 op 1 hr. rec. 150' vho&gcm
120' free oil 1120/20"
DST 3157-90 op 1 hr. rec 65' hocm,
420' froggy oil, 1140#
5 $\frac{1}{2}$ " @ 3446, 18/ 3184-87, 1000 A
F/ 30 to 50 boph,
Comp. 300 BOPD
Anh. 672'
H. 2985'
BL. 3096
L. 3112
C. 3393
A. 3488
TD 3448'

COMPLETED

County Barton Elev. _____
 Sec. 37 Twp. 18 Rge. 11W
 Company Thunderbird
 Farm Name Kimpler #C# No. 1

Co.

TOPS	DEPTH	LOG	DATUM
Anh.			
Tp.			
H.			
Tr.			
Dg.			
Bl.			
L.			
K.C.			
B.K.C.			
Ce.			
C.			
M.			
M.			
K.			
Mz.			
Me.			
V.			
S.			
S.			
A.			
R.			
PE.			
G.			
T.B.			

Loc. in Sec. SW NE NE
 Geol. _____
 Contr. _____
 Co. tools _____
 Pool _____

Lse.

DEC 7 '55
 FIRST REPORT

No.

Date Comm. 12-3-55
8" @ 183/135 drlg. 2123

Sec.

T.

R.

(Handwritten signature/initials)

County Barton Elev. 1828
 Sec. 31 Twp. 18 Rgs. 11W
 Company Thunderbird
 FarmName Kimpler "C" No. 1

TOPS	DEPTH	LOG	DATUM	Loc. in Sec.
Anh.	<u>672</u>			SW NE NE
TP.				
H.	<u>2985</u>		<u>1157</u>	
Tr.				
Dg.				
BL.	<u>3196</u>		<u>1268</u>	
L.	<u>3112</u>		<u>1284</u>	Geol.
K.C.				
B.K.C.				Contr.
Ce.				
C.	<u>3393</u>		<u>1565</u>	Co. tools
M.				
M.				Pool
K.				
Mz.				
Mo.				
V.				
S.				
S.				
A.	<u>3438</u>		<u>1610</u>	COMPLETE
R.				
Pe.				
G.				
T.D.	<u>3448</u>			

Date Comm. 12-3-55 JAN 1 1 1956

8" @ 183/135 DST 3114-45 open 1 hr.

rec. 150' who & gcm 120' free oil

1120/20" DST 3157-90 open 1 hr.

rec. 65' hocm 420' froggy oil 1140#

5 1/2" @ 3146 18/ 3184-87 1000 A

F/ 30 to 50 boph Comp. 300 bopd