

KANSAS


Barton

Section 12 Township 20 Range 11W

Well No. 3 Berscheidt

Company N C R A

Silica Pool
NORTH

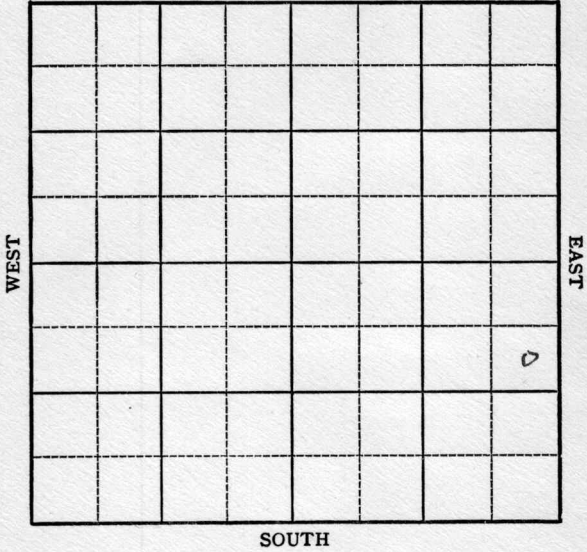

Barton

Sec. 12 Twp. 20 R. 11W ✓

Well No. #3 Berscheidt Farm

N C RA

Company

Silica Pool


990' Ft. from N. Line

_____ Ft. from S. Line

330' Ft. from E. Line

_____ Ft. from W. Line

SE NE SE

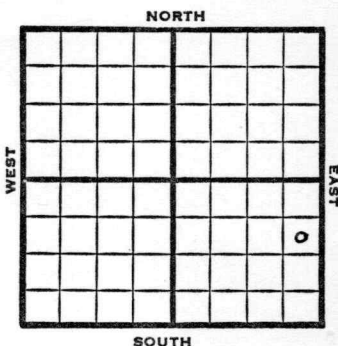

1949

Elev 1762' REPORT

2/16 Location
 2/23 "
 3/2 8" @ 161'
 3/8 Drlg 2465'
 3/16 TD 3325 in Cong.
 Lans. 3044'
 Cong 3288'
 Aband.

ABANDONED

Map No. _____ Sec. 12 Twp. 20 R. _____

Well No. 3 Berscheidt

N C R A

Company _____

FIRST REPORT

Contractor _____

SE NE SE

SECTION PLAT

990 Ft. from N. Line

_____ Ft. from S. Line

330 Ft. from E. Line

_____ Ft. from W. Line

Barton County

Location X

Rig up _____

Drilling and Remarks:

RECORD

Cased _____ in., _____ ft.

Sand _____

Gas _____

Oil _____

Total Depth _____

PRODUCTION

1st 24 hrs. Nat. _____

1st 24 hrs. after shot _____

Gas _____ Cu. Ft.

Dry Hole _____

Abandoned _____

Date

FEB 16 1949 19

S. J. LEWIS Scout

Kansas

Silica Pool

Map No. 46 Sec. 12 Twp. 20 R. 11W

Well No. 3 Berscheidt

N C R A

Company

ABANDONED

Contractor

E 11762

SE NE SE

SECTION PLAT

990 Ft. from N. Line

_____ Ft. from S. Line

330 Ft. from E. Line

_____ Ft. from W. Line

Barton County

Location _____

Rig up _____

Drilling and Remarks:

*Same 3044
Cong 3287.*

RECORD

Cased _____ in., _____ ft.

Sand _____

Gas _____

Oil _____

Total Depth 3925 in Cong

PRODUCTION

1st 24 hrs. Nat. _____

1st 24 hrs. after shot _____

Gas _____ Cu. Ft.

Dry Hole _____

Abandoned _____

Date

MAR 16 1949 19

S. J. LEWIS Scout