

31

18

11 W

Section _____ Township _____ Range _____

Well No. # 2 Roth

Company Virginia Drlg.

NORTH

WEST

EAST


0							

SOUTH

Barton KANSAS ✓

Sec. 31 Twp. 18 R. 11WWell No. #2 Roth FarmVirginia Drlg. CompanyVirginia Drlg. Contractor
Wikert Pool Ft. from N. Line990 Ft. from S. Line Ft. from E. Line330 Ft. from W. Line

NW SW SW

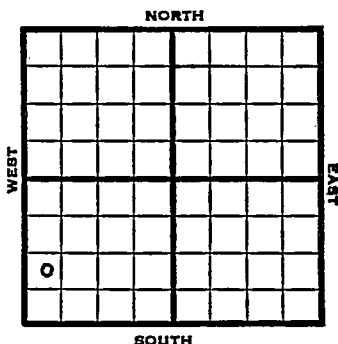

1953 Elev. 1844' REPORT

7/22 RUR

7/29 Drlg.

8/5 D & A

8/12 Spud 7-20-53

D & A

TD 3516'

8" @ 205'

Anhy 675', Lans 3142


DST 3148-75 opn 1 hr, rec 450' gas,
60' socm, 120# Cong 3397', Arb 3455'

TD 3516'

D & A

ABANDONED

County Barton State Kansas
 Sec. 31 (Blk. 18 (Sur. 11W Map No.)
 (Twp.) (Rge.)
 Operator Virginia Drlg.
 Well No. 2 Farm Roth
 Elev. 1844 Location NW SW SW

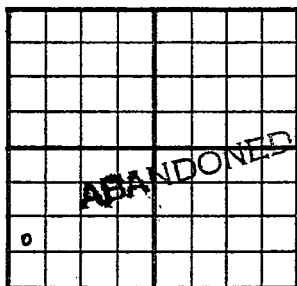

990 Ft. From S Line SW
330 Ft. From W Line Quarter

1st. Report

Completion AUG 12 1953

Remarks Weikert Pool

Virginia Drlg. - Contr.

Spudding Date 7-20-53

Drlg. Data D & A TD 3516

8" @ 205 Anhy 675 Lans. 3142

DST 3148-75 open 1 hr. Rec. 450' gas

60' socm 120# Cong. 3397 Arb. 3455

TD 3516

D & A

J. G. McGEHEE