

Barton


KANSAS

11 W

Section 31 Township 18 Range 11 W

Well No. # 1 Roth

Company Virginia Drlg.

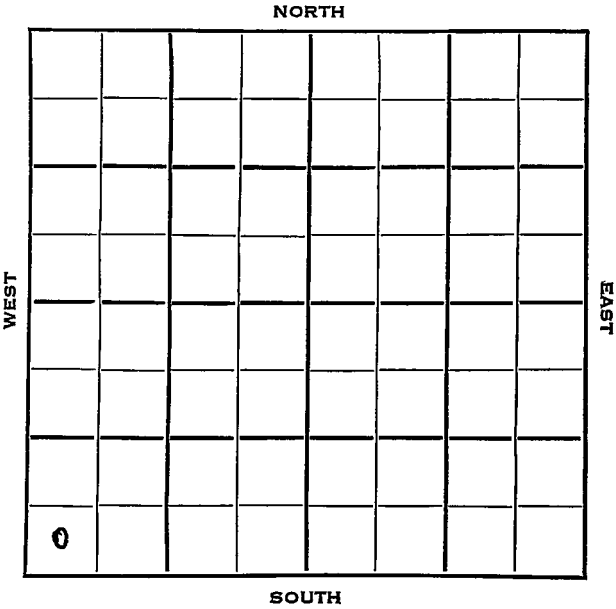

Barton

KANSAS
11W

31

18

Sec. _____ Twp. _____ R. _____

#1 Roth

Well No. _____ Farm _____

Virginia Drlg.

Company _____

Virginia Drlg.

Contractor _____

_____ Ft. from N. Line

330


_____ Ft. from S. Line

_____ Ft. from E. Line

330

_____ Ft. from W. Line

SW SW SW

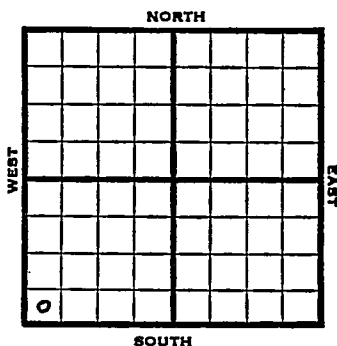

1953

Elev. 1838' REPORT

6/10

Location

6/24

8" @ 194'

Anhy 670'

Drlg 3094'

7/1

RTD 3171'

5" @ 3165'

7/8

NR

7/22

"

7/29

"

8/5

Spud 6-15-53

Oil Well

TD 3171'

8" @ 194'

Anhy 670, Heeb 3010, Br. Lime 3122,

Lans 3138

TD 3171'

5" @ 3165'

CO to 3171'


500 A 3 bw F/ 40 bo 50 bw F/ 10

boph

Comp. 135 bopd.

COMPLETED

J. G. McGEHEE

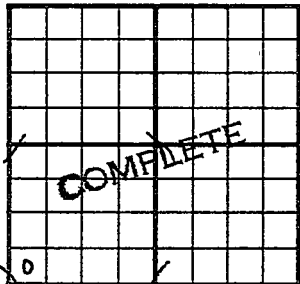County Barton State KansasSec. 31 (Blk.) 18 (Sur.) 11W Map No.Operator Virginia Drlg.Well No. 1 Farm RothElev. 1838 Location SW SW SW330 Ft. From S Line SW330 Ft. From W Line Quarter

1st. Report

Completion Aug 5 1953

Remarks

Virginia Drlg. - Contr.Spudding Date 6-15-53Drlg. Data Oil well TD 31718" @ 194 Anhy 670 Heeb. 3010Br. lime 3122 Lans. 3138 TD 31715" @ 3165 CO to 3171 500 A 3 bwF/ 40 bo 50 bw F/ 10 bophComp. 135 bopd

J. G. McGEHEE