


Section 32 Township 18 Range 11 W

Well No. # 1 Habiger

Company ~~Shelly Miller~~ ASH-MAR

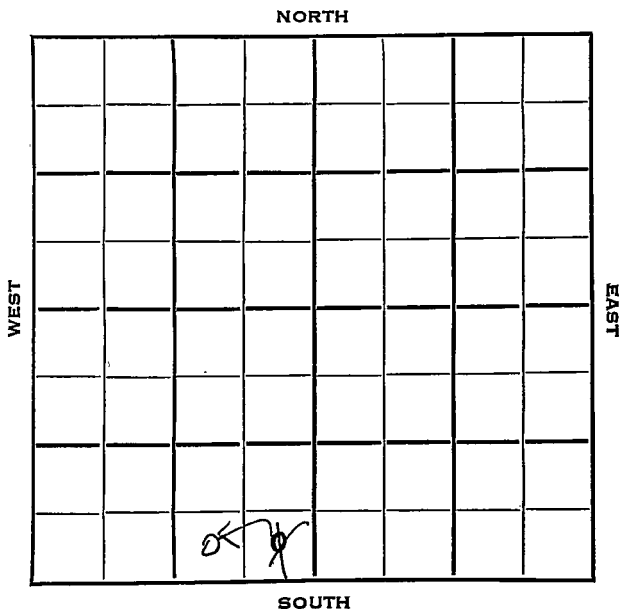

Barton

KANSAS ✓

Sec. 32 Twp. 18 R. 11W

Well No. #1 Habiger Farm

~~Shelly-Miller~~ ASH-MAR Company

Shelly-Miller Contractor
Beiberle Pool


Ft. from N. Line

330 Ft. from S. Line

330/990 Ft. from E. Line

Ft. from W. Line

~~SE SE SW~~
SW

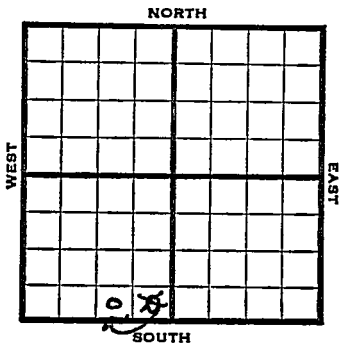

1953

Elev. 1827'

REPORT

5/20 RUR

5/28 8" @ 189 '
Dr1g 2120'

6/3 Spud 5-19-53 . D & A TD 3466
8" @ 189 Heeb 3002' Br line 3118
Lans 3133 Arb. 3442 TD 3466
D & A

ABANDONED

Map No. _____ Sec. 32 Twp. 18 R. 11W

Well No. 1 Habiger

Ash-Mar _____ Company

CORRECTION

Contractor

SW SE SW

SECTION PLAT

_____ Ft. from N. Line

330 Ft. from S. Line

990 Ft. from E. Line

_____ Ft. from W. Line

| | | | |
|--|--|--|--|
| | | | |
| | | | |
| | | | |
| | | | |
| | | | |

Handwritten: 2nd 1/4 SW of SW 1/4

corrected SW of SW

Barton County

Location _____

Rig up _____

Drilling and Remarks:

Reported
Shelly-Miller
#1 Habiger

SESE SW

Cased _____ in. _____ ft

Sand _____

Gas _____

Oil _____

Total Depth _____

PRODUCTION

1st 24 hrs. Nat. _____

1st 24 hrs. after shot _____

Gas _____ Cu. Ft.

Dry Hole _____

Abandoned _____

Date

MAY 27, 1953

J. G. MCGEHEE

Scout

