


Barton

Section 12 Township 20 Range 11-W

Well No. 3 Nicholas

Company Gulf

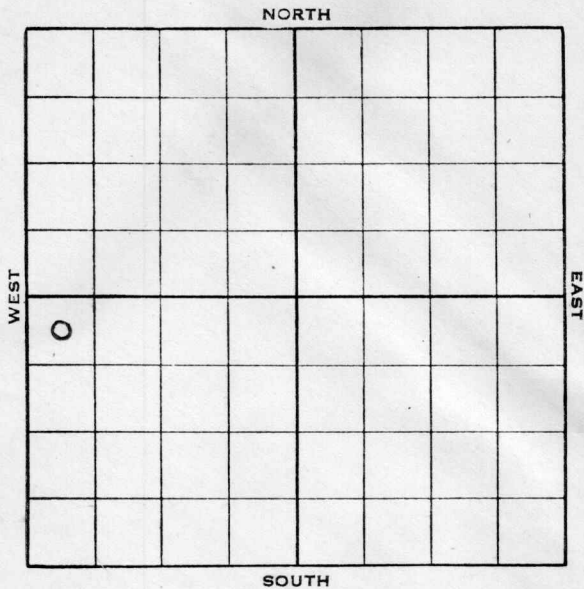

Sec. 12 Twp. 20 R. 11-W

Well No. #3 Nicholas Farm
Gulf Company


330 Ft. from N. Line

_____ Ft. from S. Line

_____ Ft. from E. Line

330 Ft. from W. Line

Elev. 1762

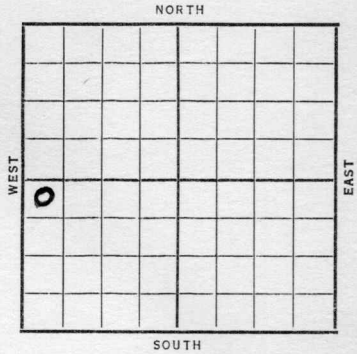

Date	REPORT
1938	
2/9	R. R.
2/18	10" @ 182'. Drlg. 2165'.
2/26	Drlg. 3168'.
3/4	Arb. 3275'. T.D. 3283'. 6" @ 3275'.
	Swab 167 oil in 6 hrs. 2000 acid.
3/9	6" @ 3275'.
	Arb. 3275'.
	T.D. 3283'.
	2000 acid.
	Potential 1969 bbls.
	COMPLETED

Map No. _____ Sec. 12 Twp. 20 R. 11W

Well No. 3 Nicholas

Gulf Company

FIRST REPORT Contractor _____

SECTION PLAT

NW SW

330 Ft. from N. Line

_____ Ft. from S. Line

_____ Ft. from E. Line

330 Ft. from W. Line

0			

Location _____

Rig up _____

Drilling and Remarks:

RR

RECORD

Cased _____ in., _____ ft.

Sand _____

Gas _____

Oil _____

Total Depth _____

PRODUCTION

1st 24 hrs. Nat. _____

1st 24 hrs. after shot _____

Gas _____ Cu. Ft.

Dry Hole _____

Abandoned _____

Date

FEB 9 1938 19

H. D. Hatfield Scout

Map No. 46 Sec. 12 Twp. 20 R. 11W

Well No. 3 Nicholas

Gulf

Company

Contractor

COMPLETED

SECTION PLAT

NW SW

330 Ft. from N. Line

_____ Ft. from S. Line

_____ Ft. from E. Line

330 Ft. from W. Line

0			

Location _____

Rig up _____

Drilling and Remarks:

2000 acid

POT 1969

RECORD

Cased 6 in. 3275 ft.

Sand Arb 3275

Gas _____

Oil _____

Total Depth 3283

PRODUCTION

1st 24 hrs. Nat. _____

1st 24 hrs. after shot _____

Gas _____ Cu. Ft.

Dry Hole _____

Abandoned _____

Date

MAR 9 - 1938

19

H. D. Hatfield Scout