


Barton

KANSAS

Section 12 Township 20 Range 11-W

Well No. 1 Spanier "B"

Company Gulf

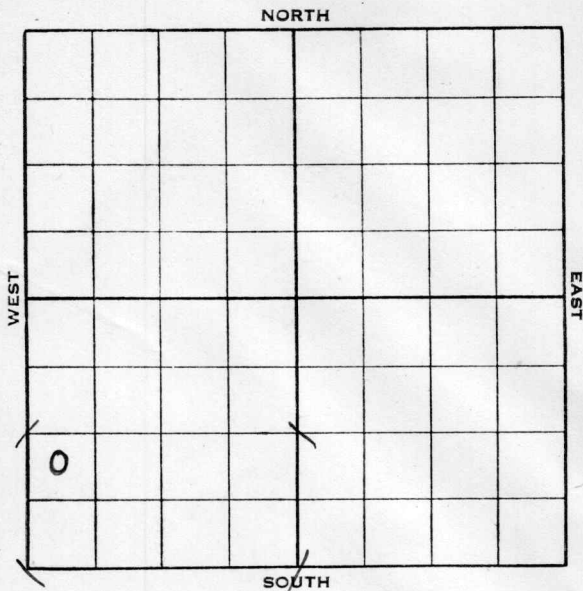

Barton

KANSAS

Map No. 46 Sec. 12 Twp. 20 R. 11WWell No. 1 Spanier "B"Gulf

Company

Contractor

FIRST REPORT

NW SW SW

Ft. from N. Line

990


Ft. from S. Line

Ft. from E. Line

330

Ft. from W. Line

SECTION PLAT

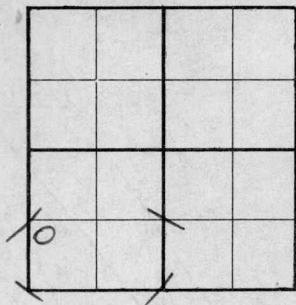

Location _____

Rig up _____

Drilling and Remarks:

Cellar

RECORD

Cased _____ in., _____ ft.

Sand _____

Gas _____

Oil _____

Total Depth _____

PRODUCTION

1st 24 hrs. Nat. _____

1st 24 hrs. after shot _____

Gas _____ Cu. Ft.

Dry Hole _____

Abandoned _____

Date

JUL 20 1938 19

H. D. Hatfield

Scout

Barton

KANSAS

Map No. 46 Sec. 12 Twp. 20 R. 11WWell No. 1 Spanier "B"

Gulf

Company

Contractor

COMPLETED

NW SW SW

SECTION PLAT

o			

Ft. from N. Line

990 Ft. from S. Line

Ft. from E. Line

330 Ft. from W. Line

Location _____

RECORD

Rig up _____

Drilling and Remarks:

2000 acidRot. 2534JumpCased _____ in., _____ ft.
Sand 3263

Gas _____

Oil _____

Total Depth 3273

PRODUCTION

1st 24 hrs. Nat. _____

1st 24 hrs. after shot _____

Gas _____ Cu. Ft.

Dry Hole _____

Abandoned _____

Date

SEP 7 - 1938 19

ORVAL MANNSCHRECK

Scout