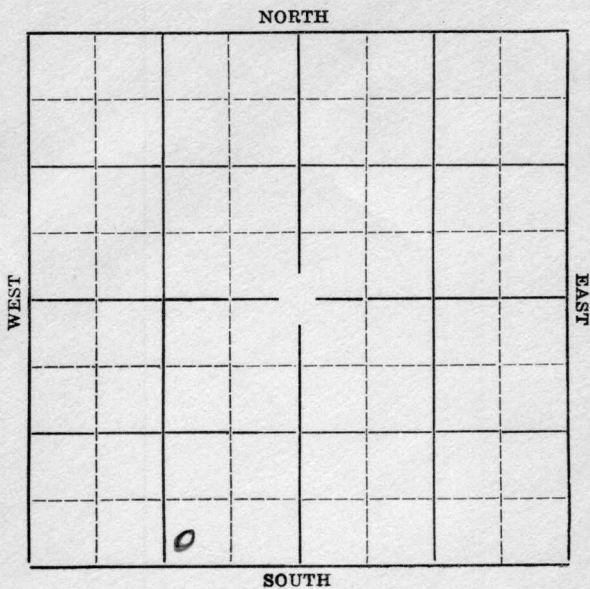


Section 13 Township 20 Range 11-WWell Number #2 MeyersCompany Lario & I.T.I.O.

KANSAS


Barton

Sec. 13 Twp. 20 R. 11WWell No. #2 Meyers FarmLario & I.T.I.O. Company

_____ Ft. from N. Line

330' Ft. from S. Line

_____ Ft. from E. Line

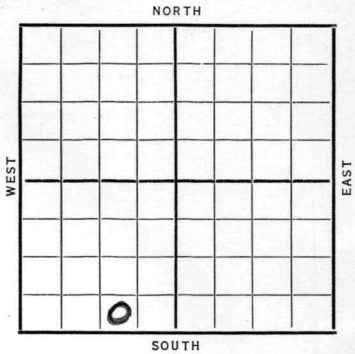1384' Ft. from W. LineElev 1757~~1936~~

REPORT

10/7 Cellar.

10/15 Surface hole.

10/22 Drl g. 2380'.

10/29 3261' coring.

11/6 Sil. 3262 Set 7" T. D. 3274
Flow 49 bbls per hr.

11/10 Sil. 3262 T. D. 3274
Pump & Flow 2210 bbls.

COMPLETED

KANSAS

Map No. 46 Sec. 13 Twp. 20 R. 11W

Well No. 2 Meyers

Larion & J.T.D. Company

Contractor

SECTION PLAT

 Ft. from N. Line

330 Ft. from S. Line

 Ft. from E. Line

1384 Ft. from W. Line

FIRST REPORT

Location

Rig up

Drilling and Remarks:

Cellar

RECORD

Cased in., ft.

Sand

Gas

Oil

Total Depth

PRODUCTION

1st 24 hrs. Nat.

1st 24 hrs. after shot

Gas Cu. Ft.

Dry Hole

Abandoned

Date

OCT 7 1936

S. J. LEWIS Scout

Map No. 46 Sec. 13 Twp. 20 R. 11WWell No. 2 MeyersLasia & S. V. L. O. Company

Contractor

SECTION PLAT

_____ Ft. from N. Line

830 Ft. from S. Line

_____ Ft. from E. Line

1384 Ft. from W. Line

COMPLETED

Location _____

Rig up _____

Drilling and Remarks:

Sit 3262.Pump & Flow.2210 & 6

RECORD

Cased _____ in., _____ ft.

Sand _____

Gas _____

Oil _____

Total Depth 3274

PRODUCTION

1st 24 hrs. Nat. _____

1st 24 hrs. after shot _____

Gas _____ Cu. Ft.

Dry Hole _____

Abandoned _____

Date

NOV 10 1936

19

S. J. LEWIS Scout