

# KANSAS

Form 51-5M-7-40-Palace


Barton

Section 13 Township 20 Range 11-W

Well No. #3 Meyer

Company Gulf

NORTH Silica Pool

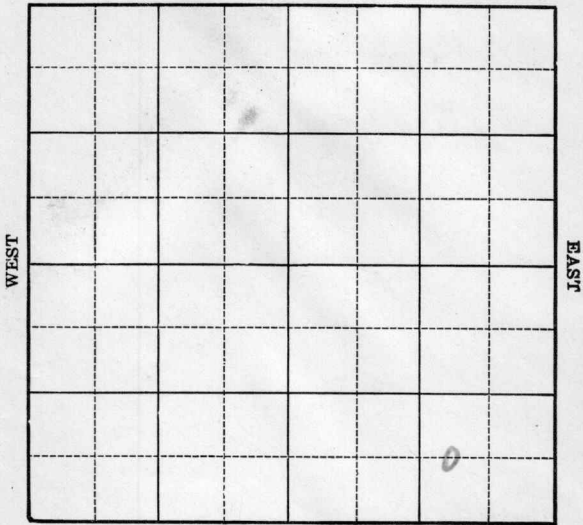

SOUTH

Sec. 13 Twp. 20 R. 11-W

Well No. #3 Meyer Farm

Gulf Company

(Silica)


\_\_\_\_\_ Ft. from N. Line

660 Ft. from S. Line

990 Ft. from E. Line

\_\_\_\_\_ Ft. from W. Line

Elev. 1749

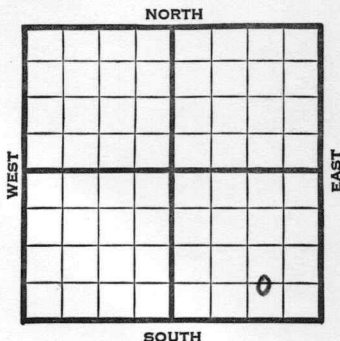

1941	REPORT
4/2	8" - 168'
	Drlg. 1395'
4/10	Drlg. 2895'
4/18	Arb. 3251' SO 3252-53'
	5½" - 3252' RUST.
4/23	Arb. 3251'
	5" - 3252'
	T.D. 3256½'
	2000 acid.
	Soniometer potential 4865 bbls.
	Maximum 3000 bbls.
	45. Gravity
	COMPLETED

Map No. 46 Sec. 13 Twp. 20 R. 11W

Well No. 3 Meyer

Gulf Company

**FIRST REPORT** Contractor

C W L SE SE

**SECTION PLAT**

			o

         Ft. from N. Line

660 Ft. from S. Line

990 Ft. from E. Line

         Ft. from W. Line

SILICA POOL

Location                                 

Rig up                                 

Drilling and Remarks:

8" - 168

Dr lg. 1395

**RECORD**

Cased          in.,          ft.

Sand                                 

Gas                                 

Oil                                 

Total Depth                         

**PRODUCTION**

1st 24 hrs. Nat.                         

1st 24 hrs. after shot                         

Gas                                  Cu. Ft.

Dry Hole                                 

Abandoned                                 

Date

APR 2 1941 19

S. J. LEWIS Scout

Map No. 46 Sec. 13 Twp. 20 R. 11W

Well No. 3 Meyer

Gulf Company

COMPLETED Contractor

SECTION PLAT

			o

C W L SE SE

         Ft. from N. Line

660 Ft. from S. Line

990 Ft. from E. Line

         Ft. from W. Line

Silica Pool

Location                                 

Rig up                                 

Drilling and Remarks:

*Ce 8 3251*  
*5" C 3252*  
*2000 acid*  
*Sonicmeter Pat.*  
*4765*  
*Wt 3000*  
*4.5° Gr*

RECORD

Cased          in.,          ft.

Sand                                 

Gas                                 

Oil                                 

Total Depth 3256 1/2

PRODUCTION

1st 24 hrs. Nat.                         

1st 24 hrs. after shot                         

Gas                                  Cu. Ft.

Dry Hole                                 

Abandoned                                 

Date

APR 23 1941 19

S. J. LEWIS Scout