
FORM 51 25M 8-50 WESTERN Barton KANSAS

Section 32 Township 18 Range 11 W

Well No. # 1 Habiger

Company Tsern Drlg.

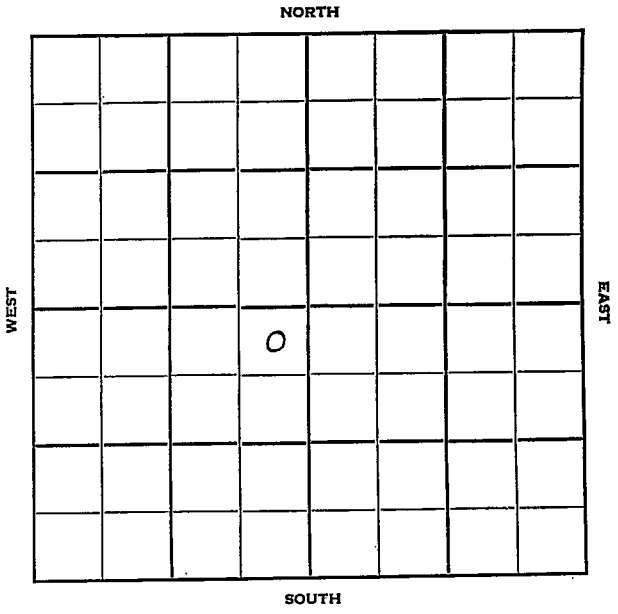

FORM 252-B
10M 11-50 PETROL

Barton KANSAS

Sec. 32 Twp. 18 R. 11 W

Well No. # 1 Habiger Farm

Isern Drlg. Company

Contractor

Wildcat


330 Ft. from N. Line

Ft. from S. Line

330 Ft. from E. Line

Ft. from W. Line

NE NE SW

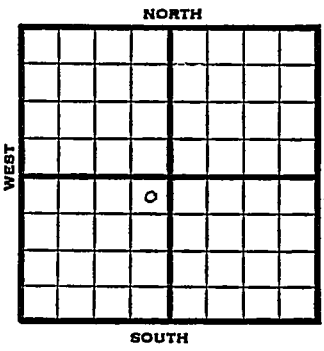

1951	Elev. 1839' REPORT
5/23	Location
6/5	Spud 5-25-51 D&A TD 3470 8" @ 163 Top 2661 Heeb. 3009 Br lime 3125 KC 3141 Sdy Cong. 3422 Ch Cong. 3425 Arb. 3439 TD 3470 DST 3143-3215 opn 45 min. Rec. 20' mud DST 3409-49 opn 50 min. Rec. 60' mud w/SSO D&A ABANDONED

FORM 275 FOR SALE BY KANSAS BLUE PRINT CO.


County Barton State Kansas

Sec. 32 (Blk. Twp.) 18 (Sur. Rge.) 11W Map No.

Operator Isern Drlg.

Well No. 1 Farm Habiger

Elev. Location NE NE SW

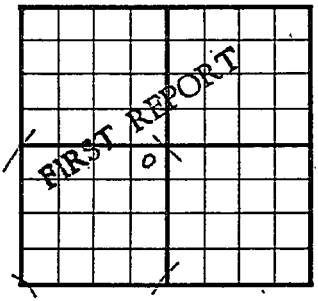

330 Ft. From N Line SW

330 Ft. From E Line Quarter

1st. Report MAY 23 1951

Completion

Remarks

Spudding Date

Drlg. Data Wildcat

Location

J. E. TYRA

FORM 275 FOR SALE BY KANSAS BLUE PRINT CO.


County Barton State Kansas

Sec. 32 (Blk. Twp.) 18 (Sur. Rge.) 11W Map No.

Operator Isern Drlg.

Well No. 1 Farm Habiger

Elev. 1839 Location NE NE SW

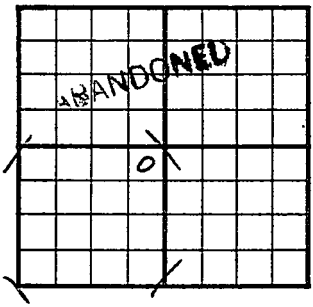

330 Ft. From N Line SW

330 Ft. From E Line Quarter

1st. Report

Completion JUN 6 1951

Remarks Wildcat

Spudding Date 5-25-51

Drlg. Data D & A TD 3470

8" @ 163 Top. 2661 Heeb. 3009

Br. lime 3125 KC 3141 Sdy Cong. 3422

Ch, Cong. 3425 Arb. 3439 TD 3470

DST 3143-3215 open 45 min. Rec. 20' mud

DST 3409-49 open 50 min. Rec. 60' mud

w/ SSO D & A

U. L. TYRA