

Barton


KANSAS

SECTION 32 TOWNSHIP 18 RANGE 11 W

WELL NO. #1 P. P. Kimpler

COMPANY Texas Co.

NORTH

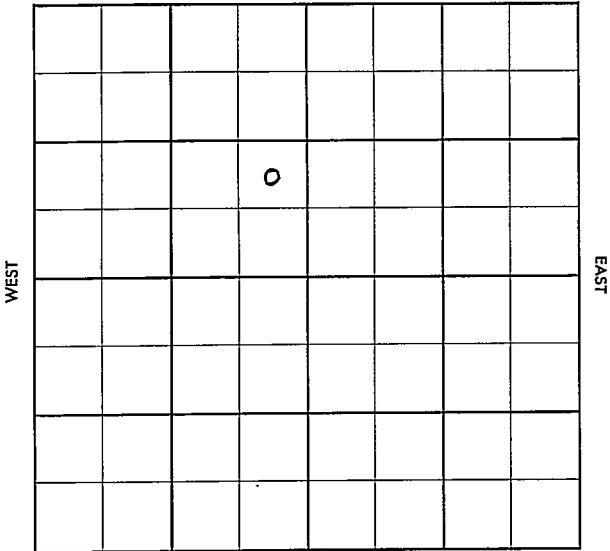

SOUTH

SEC. 32	TWP. - - 18	R. 11W
------------	----------------	-----------

WELL NO. #1 P.P. Kimpler FARM

COMPANY Texas Company

CONTRACTOR Braden


St. Peter

_____ Ft. from N. Line

_____ Ft. from S. Line

_____ Ft. from E. Line

_____ Ft. from W. Line

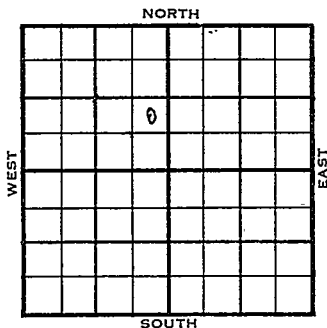

NE SE NW

1956	ELEVATION 1846	REPORT
------	-------------------	--------

2-1 Comm. 1-27-56
10" @ 674
Drl.g 1850

County **Bayton** Elev. **1846**
 Sec. **32** Twp. **18** Rge. **11W**
 Company **Texas Company**
 Farm Name **P. P. Kimpler** No. **1**

TOPS	DEPTH	LOG	DATUM
Anh.			
Tp.			
H.			
Tr.			
Dg.			
Bl.			
L.			
K.C.			
B.K.C.			
Ce.			
C.			
M.			
M.			
K.			
Mz.			
Me.			
V.			
S.			
S.			
A			
R.			
Pe.			
G.			
T.D.			

Loc. in Sec. **NE SE NW**

Geol. _____
 Contr. **Braden**

Pool **St. Peter**

FEB 1 '56	
FIRST REPORT	

Date Comm. **1-27-56**
10" @ 674 drlg. 1850

[Handwritten signature]

Co.

Lse.

A No.

Sec.

T.

R.

County Barton Elev. 1816
 Sec. 32 Twp. 18 Rge. 11W
 Company TEXAS COMPANY
 Farm Name P. P. Kimpler No. 1

	TOPS	DEPTH	LOG	DATUM
Asb.				
T.P.			2749	
H.		3013	3012	
Jr.				
Bg.				
Bl.		3128	3124	1278
L.		3142	3142	1276
KC.				
AKC.				
Cc.			3409	1563
C.				
M.				
K.				
E.				
Ma.				
V.				
S.				
A.			3441	1595
R.				
E.				
S.				
TA.		3450		

Loc. in Sec. NE SE NW

Geol. _____
 Conts. _____
Bradon

Pool St. Peter

ABANDONED

FEB 22 1956

Date Com. 1-27-56

10" @ 674 drlg. 1850 FEB 15 '56

ord 3164-74 rec 10' DST 3120
 = 75' rec 30" rec 33' WM BHP
 840/20 ord 3206-16 rec 10'
 crg ahead FEB 15 '56 DST 3201-21
 lbs rec 40' WM BHP 490/20
 ord 3420-50 rec 30' FEB 22 '56

N. G. R. (Hold)