


Barton

Form 51-5M-11-31-Palace

Map No. **KANSAS** Sec. *12* Twp. *20* R. *11W*

Well No. *3-A Larn* Farm
Hilligoss et al Company

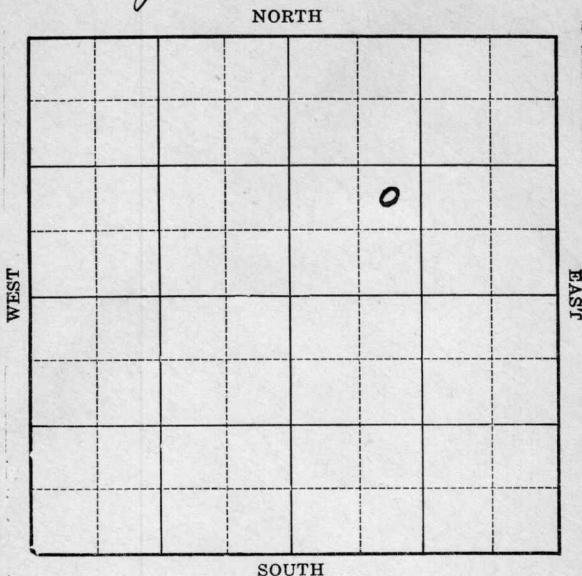

Location _____

Drilling Remarks _____

Rig Up _____

Drilling Remarks _____

RECORD

Cased _____ in. _____ ft.

Sand _____

Gas _____

Oil _____

Total Depth _____

PRODUCTION

1st 24 hrs. Nat. _____

1st 24 hrs. after shot _____

Gas _____ cu. ft.

Dry Hole _____

Abandoned _____

Barton

Map No. KANSAS Sec. 12 Twp 20 R. 11W

Well No. 3-A Jern Farm


Hilligoss et al Company

990 Ft. from N. Line

Ft. from S. Line

Ft. from E. Line

990 Ft. from W. Line

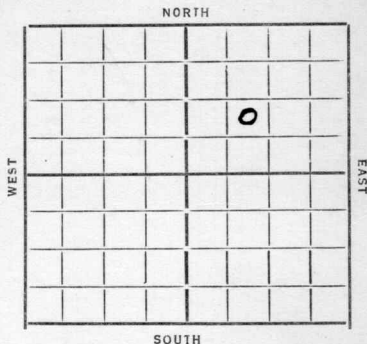

Date 7/9/34

REPORT

4/25 Rig
5/3 Rig
5/10
5/18 Rign up
5/25 Dlg 1025 15" 111 12" 481
5/31 " 1726
6/7 " 2050 10" 2015
6/14 Dlg 2228
6/21 " 2820 8" 2560
6/28 6" 3244 Nil 3300
TD 3313 v.o.
7/5 Est 50 Bbls per day 1000 acid
7/12 Testing
7/18 Silicious 3300 TD 3338
Est 50 Bbls oil 1000 acid
H7W D & A

ABANDONED

KANSAS


Map No. 46 Sec. 12 Twp. 20 R. 11WWell No. 3A-2 sec 12Hilligass et al

Company

Contractor

FIRST REPORTS

SECTION PLAT

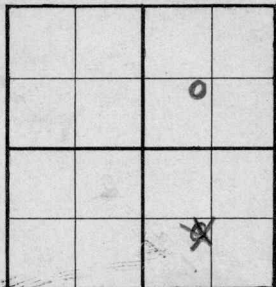

_____ Ft. from N. Line

990 Ft. from S. Line

_____ Ft. from E. Line

990 Ft. from W. Line

Location _____

Rig up _____

Drilling and Remarks:

Rig

RECORD

Cased _____ in., _____ ft.

Sand _____

Gas _____

Oil _____

Total Depth _____

PRODUCTION

1st 24 hrs. Nat. _____

1st 24 hrs. after shot _____

Gas _____ Cu. Ft.

Dry Hole _____

Abandoned _____

Date

4-25-34 19

ORVAL MANNSCHRECK

Scout

Map No. 46 Sec. 12 Twp. 20 R. 11WWell No. 3A-2serwHelligass et al Company

Contractor

ABANDONED

SECTION PLAT

		0	

____ Ft. from N. Line

990 Ft. from S. Line

____ Ft. from E. Line

990 Ft. from W. Line

Location _____

Rig up _____

Drilling and Remarks:

Est. 50 bbls oil.
1000 acid.
HFW

NOV

RECORD

Cased _____ in., _____ ft.

Sand silicious 3300

Gas _____

Oil _____

Total Depth 3338

PRODUCTION

1st 24 hrs. Nat. _____

1st 24 hrs. after shot _____

Gas _____ Cu. Ft.

Dry Hole _____

Abandoned _____

Date

7-18-34 19

Scout

ORVAL MANNSCHRECK