

Barton


KANSAS

Section 32 Township _____ Range 11W

Well No. #2 Robl

Company Shelly-Miller Drlg.

NORTH

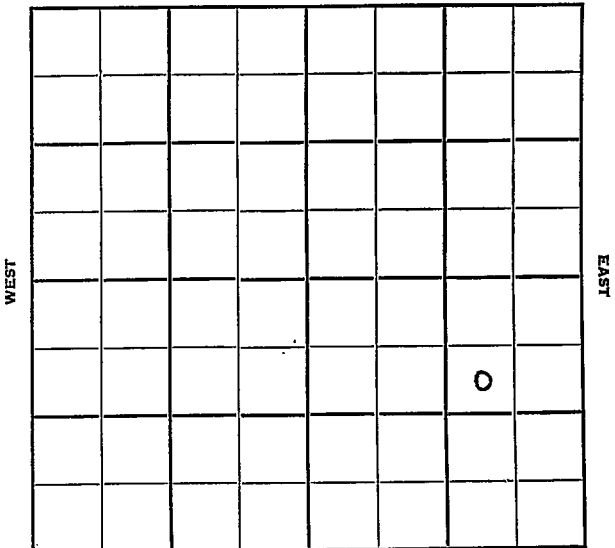

SOUTH

Sec. 32 Twp. 18 R. 11W

Well No. #2 Robt Farm

Shelly-Miller Drlg. Company


Shelly-Miller Contractor
Bieberle Pool

990 Ft. from N. Line

_____ Ft. from S. Line

990 Ft. from E. Line

_____ Ft. from W. Line

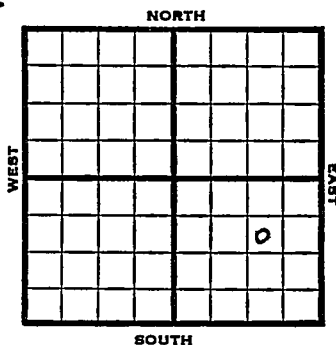

SW NE SE

1953 Elev. 1828' REPORT

5/27 M I R
 6/3 8" @ 160'
 Anhy 627', Heeb 2949, Br. L. 3068,
 Lans 3084
 Drlg 3233
 6/10 Cong 3358, Arb 3370
 RTD 3373
 Schl.
 5" @ 3371'
 6/24 CO 3373
 3 boph 500 A no inc. DD 3385 TD
 6 boph 1000 A 7 boph 3 hrs. POP
 8/1 Spud 5-25-53
 Oil well TD 3385' 8" @ 160
 Anhy 627 Heeb 2949 Br lime 3068
 Lans 3084 Cong 3358 Arb. 3370
 TD 3373 5" @ 3371 CO to 3373
 3 BOPH 500 A DD 3385 6 BOPH
 1000 A 7 BOPH
 Comp. 343 BOPD 17% wtr.

COMPLETED

