


Section 12 Township 20 Range 11-WWell No. 1 NicholasCompany Gulf

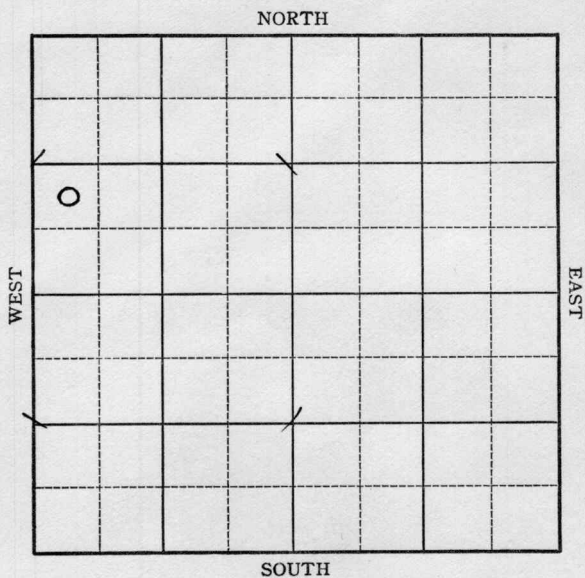

Barton

KANSAS

Map No. 46 Sec. 12 Twp. 20 R. 11WWell No. 1 Nicholas

Gulf

Company


Contractor

## FIRST REPORT

NW SW NW

       Ft. from N. Line990 Ft. from S. Line       Ft. from E. Line330 Ft. from W. Line

## SECTION PLAT

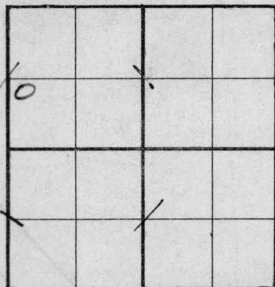Location                                 Rig up                                 

Drilling and Remarks:

10"- 174WOC

## RECORD

Cased                    in.,                    ft.Sand                                 Gas                                 Oil                                 Total Depth                                 

## PRODUCTION

1st 24 hrs. Nat.                                 1st 24 hrs. after shot                                 Gas                                  Cu. Ft.Dry Hole                                 Abandoned                                 

Date

JAN 19 1938 19H. D. Hatfield Scout

Barton KANSAS

Map No. \_\_\_\_\_ Sec. 12 Twp. 20 R. 11WWell No. 1 NicholasGulf

Company \_\_\_\_\_

Contractor \_\_\_\_\_

**COMPLETED**

NW SW NW

\_\_\_\_\_ Ft. from N. Line

990 Ft. from S. Line

\_\_\_\_\_ Ft. from E. Line

330 Ft. from W. Line**SECTION PLAT**

|   |  |  |  |
|---|--|--|--|
|   |  |  |  |
| 0 |  |  |  |
|   |  |  |  |
|   |  |  |  |

Location \_\_\_\_\_

Rig up \_\_\_\_\_

Drilling and Remarks:

*2000 acid**pot 1774***RECORD**Cased 6 in., 3272 ft.Sand Arb 3272

Gas \_\_\_\_\_

Oil \_\_\_\_\_

Total Depth 3281**PRODUCTION**

1st 24 hrs. Nat. \_\_\_\_\_

1st 24 hrs. after shot \_\_\_\_\_

Gas \_\_\_\_\_ Cu. Ft.

Dry Hole \_\_\_\_\_

Abandoned \_\_\_\_\_

Date

FEB 16 1938 19H. D. Hatfield Scout