

KANSAS

Form 51—5M—7-39—Palace

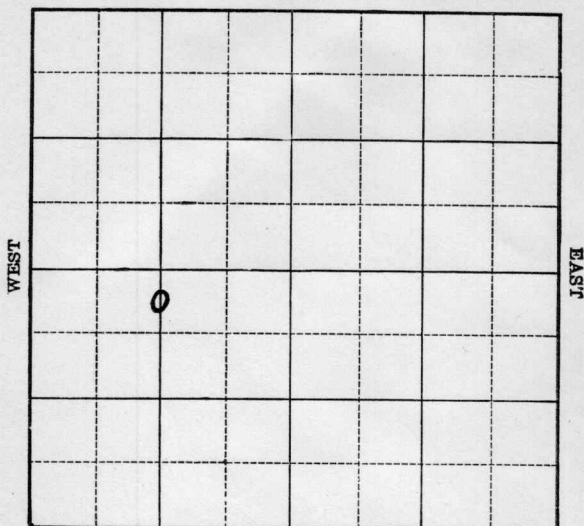
Barton

Section 12 Township 20 Range 11-W

Well No. #6 Nicholas

Company Gulf

NORTH Silica Pool



SOUTH

KANSAS

Barton

Sec. 12 Twp. 20 R. 11-W

Well No. #6 Nicholas Farm

Gulf _____ Company

(Silica)

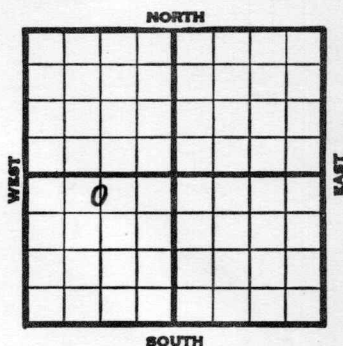
330 Ft. from N. Line

Ft. from S. Line

Ft. from E. Line

1320 Ft. from W. Line

Elev. 1761

[illegible]

Barton

KANSAS

Map No. 46 Sec. 12 Twp. 20 R. 11WWell No. 6 Nicholas

Gulf

Company

Contractor

FIRST REPORT

C N L SW

SECTION PLAT

	o		

330 Ft. from N. Line

_____ Ft. from S. Line

_____ Ft. from E. Line

1320 Ft. from W. Line

Silica Pool

Location _____

Rig up _____

Drilling and Remarks:

RIGGING UP ROTY

RECORD

Cased _____ in., _____ ft.

Sand _____

Gas _____

Oil _____

Total Depth _____

PRODUCTION

1st 24 hrs. Nat. _____

1st 24 hrs. after shot _____

Gas _____ Cu. Ft.

Dry Hole _____

Abandoned _____

Date

MAR 6 1940

19

S. J. LEWIS

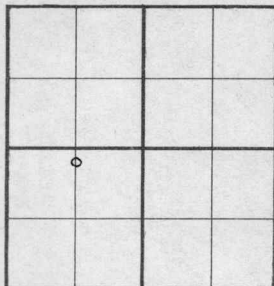
Scout

Map No. 46 Sec. 12 Twp. 20 R. 11WWell No. 6 Nicholas

Gulf

Company

Contractor

COMPLETED**SECTION PLAT**

C N L SW

330 Ft. from N. Line

Ft. from S. Line

Ft. from E. Line

1320 Ft. from W. Line**SILICA POOL**

Location _____

Rig up _____

Drilling and Remarks:

P.B. 3285Depth. Pot.
858 bbls.S.W.**RECORD**

Cased _____ in. _____ ft.

Sand Arbuckle 3275

Gas _____

Oil _____

Total Depth 3287**PRODUCTION**

1st 24 hrs. Nat. _____

1st 24 hrs. after shot _____

Gas _____ Cu. Ft.

Dry Hole _____

Abandoned _____

Date

APR 10 1940 19

S. J. LEWIS Scout