


Section 32 Township 18 Range 11 W

Well No. # 5 Robl

Company Shelly-Miller

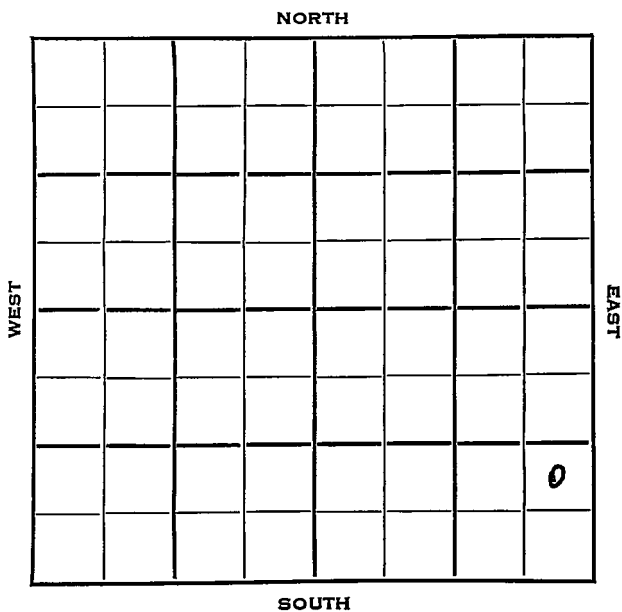

Barton

KANSAS

SEC.	TWP.	R.
32	18	11W

WELL NO.

5 Robl

FARM

COMPANY

Shelly-Miller

CONTRACTOR

Bieberle Pool


_____ Ft. from N. Line

990 _____ Ft. from S. Line

330 _____ Ft. from E. Line

_____ Ft. from W. Line

NE SE SE

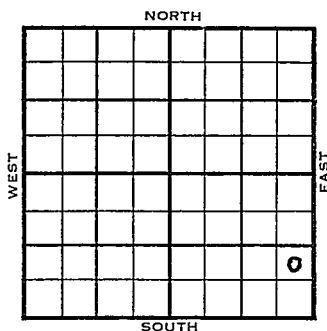

1953

ELEVATION
1825'

REPORT

9/9

Spud 9-3-53
8" @ 161

Drlg. 1990'

9/16

Heeb 2960, Br li 3077, Lans 3093
DST 3109-70, 1 hr., 1860' oil, 960#
Cong 3372, Arb 3377
RTD 3390
5" @ 3390'

9/23

NR

10/7

CO 3146' 16/3140-45 1500 A
S/15 B0 1/2 hr.

10/14

Spud 9-3-53 Oil well TD 3390
8" @ 161 Heeb 2960 Br lime 3077
Lans 3093
DST 3109-70 open 1 hr rec 1860' oil
900# Cong. 3372 Arb. 3377
TD 3390 5" @ 3390 PB 3146
16/3140-45 1500 A S/15 B0 1/2 hr.
Comp. 3000 BOPD**COMPLETED**

