


Section 32 Township 18 Range 11 W

Well No. # 7 Robl

Company Shelly-Miller

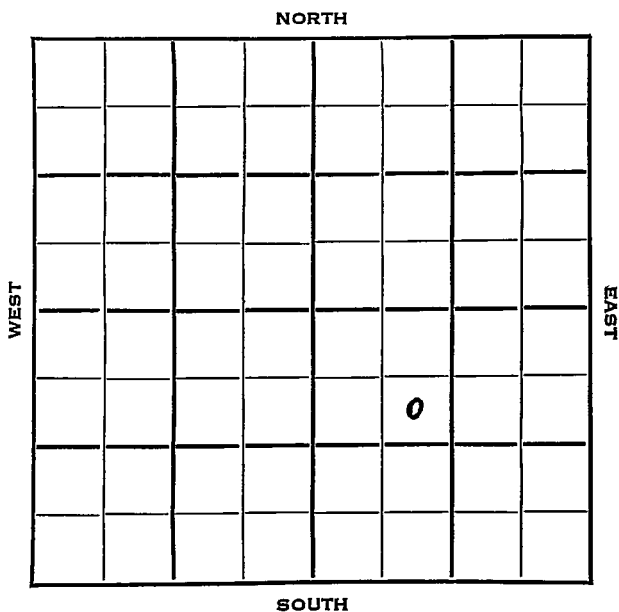

| | | |
|------|------|-------|
| SEC. | TWP. | R. |
| 32 | 18 | 11W ✓ |

WELL NO.

7 Robl

FARM

COMPANY

Shelly-Miller

CONTRACTOR

Shelly-Miller
Bieberle Pool


990 _____ Ft. from N. Line

_____ Ft. from S. Line

_____ Ft. from E. Line

990 _____ Ft. from W. Line

SE NW SE

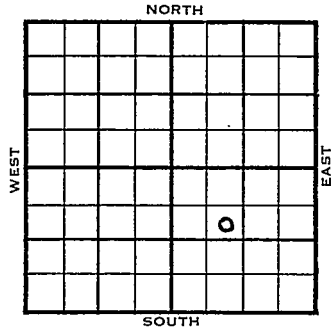

| | ELEVATION | REPORT |
|-------|--|--------|
| 1953 | 1834' | |
| 9/30 | Spud 9-26-53 8" @ 150' Drlg. 1435' | |
| 10/7 | Heeb 2967' Br li 3082' Lans 3098 DST 3101-15, 1 hr, 55' M DST 3178-90, 1/4 hr, F/oil in 1/4 hr HFO DST 3233-53, 1 hr, 60' wtr. Cong. 3377' Drlg. 3424' | |
| 10/14 | RTD 3440' 5" @ 3349 CO 3315 log 12/3157-61 24/3164-72 S & F/47 BO 2 hrs 3000 A | |
| 10/21 | F/88 BO 1/2 hr. | |
| 10/28 | Spud 9-26-53 Oil well TD 3440 8" @ 150 Heeb 2967 Br lime 3082' Lans 3098 DST 3101-15 open 1 hr rec 55' mud DST 3178-90 open 1/4 hr. F/oil 1/4 hr. HFO DST 3233-53 open 1 hr rec 60' wtr. Cong. 3377 TD 3440 5" @ 3349 CO to 3315 12/3157-61 24/3164-72 S & F/47 BO 2 hr. 3000 A F/88 BO 1/2 hr. Comp. 3000 BOPD | |

COMPLETED

County Barton State Kansas

Sec. 32 (Blk. Twp.) 18 (Sur. Rge.) 11W Map No.

Operator Shelly-Miller

Well No. 7 Farm Robl

Elev. _____ Location SE NW SE

| | | | | | |
|--|--|--|--|--|--|
| | | | | | |
| | | | | | |
990 Ft. From N Line SE

990 Ft. From W Line Quarter

1st. Report SEP 30 1953

Completion _____

Remarks _____

Shelly-Miller - Contr.

Spudding Date 9-26-53

Drlg. Data Bieberle Pool

8" @ 150 drlg. 1435

