


Map No. 1-1 Sec. 13 Twp. 20 R. 11 W
 Well No. Lario & LOTO Farm _____ Company _____

NORTH

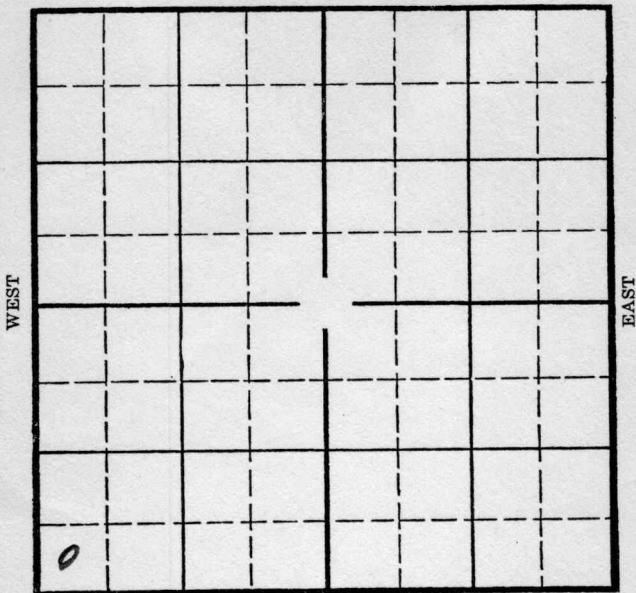

SOUTH

Location _____
 Drilling Remarks _____

Rig Up _____
 Drilling Remarks _____

RECORD

Cased _____ in. _____ ft.
 Sand _____
 Gas _____
 Oil _____
 Total Depth _____

PRODUCTION


1st 24 hrs. Nat. _____
 1st 24 hrs. after shot _____
 Gas _____ cu. ft. _____
 Dry Hole _____
 Abandoned _____

Barton
11 W

Map No. Sec. 13 Twp. 20 R.

Well No. 1-Meyer Farm
Lario & I.T.I.O. Company

NORTH

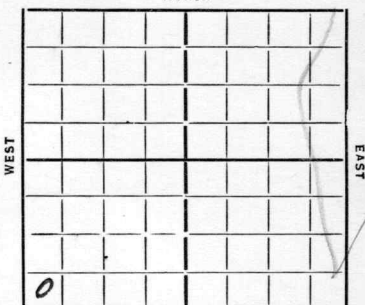

Ft. from N. Line

330

Ft. from S. Line

Ft. from E. Line

330

Ft. from W. Line

Elev. 1755

SOUTH

Date

REPORT

1935

10/24

Location

11/1

Cellar

11/7

Rig

11/14

Ry

11/21

Spud

20" 78

11/29

Alg 815

15" 482

12/4

" 1660

12" 922

12/13

10" 1922 TD 2045 W R 10"

12/19

10" 2039 TD 2235 WOC

12/26

Alg 2405

10" 2123

12/36

" 2815

1/10

Top Cong 3268

Top Sil 3275 6" 3294

Sho Oil 3305 - 9 T.D.

1/17

TD 3320 Shot 60 ft

Recommending pipe

1/24

Csg trouble

1/36

TD 3319 Run pipe

2/7

Too acid W.O.F. Gog acid

2/14

No help scrubbing test

Est 5 bbls per day

Alg 3357

OVER

2/19 Kil 3275
T 0 3389
D. A.

ABANDONED

Map No. 46 Sec. 13 Twp. 20 R. 11W

Well No. 1-Meyer

Lario + ITIO Company

Contractor

FIRST REPORTS

SECTION PLAT

Ft. from N. Line

330 Ft. from S. Line

Ft. from E. Line

330 Ft. from W. Line

Location ☒

Rig up

Drilling and Remarks:

RECORD

Cased.....in.,ft.

Sand.....

Gas.....

Oil.....

Total Depth.....

PRODUCTION

1st 24 hrs. Nat.....

1st 24 hrs. after shot.....

Gas.....Cu. Ft.

Dry Hole.....

Abandoned.....

Date

ORVAL MANNSCHRECK

10-24-35 192..... Scout

Map No. 46 Sec. 13 Twp. 20 R. 11 WWell No. 1-Meyer 'A'Lario + ITIO Company

Contractor

ABANDONED

SECTION PLAT

Ft. from N. Line

330 Ft. from S. Line

Ft. from E. Line

330 Ft. from W. Line

Location

Rig up

Drilling and Remarks:

NO + A

RECORD

Cased in. 3275 ft.~~Sand~~ Sil

Gas

Oil

Total Depth 3389

PRODUCTION

1st 24 hrs. Nat.

1st 24 hrs. after shot

Gas Cu. Ft.

Dry Hole

Abandoned

Date

2-19-36 192 ORVAL MANNSCHRECK Scout