


Barton KANSAS

Section 13 Township 20 Range 11-W

Well Number 1 W.Meyer

Company Gulf

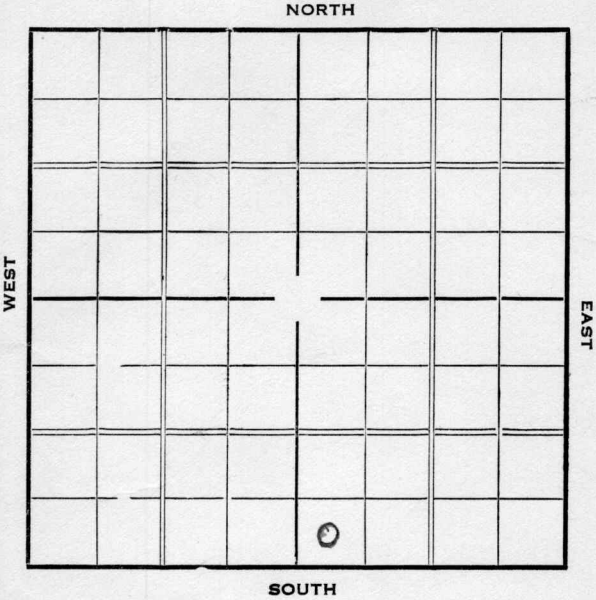

1937

3/18 Drlg. to 3335' show water plug
back 3330'.

3/25 " "

4/2 " "

4/8 " "

4/16 " "

4/23 " "

4/30 SD 3330'.

5/7 " "

5/14 " "

5/21 " "

5/28 " "

6/4 " "

6/11 Drlg. 3338'.

6/19 SD 3338'.

6/25 " "

7/2 " "

7/9 " "

7/14 7" @ 3262'.

Sil. 3261'.

T.D. 3335'.

Minimum Well.

15 bbls. per day.

COMPLETED

KANSAS

Map No. 46 Sec. 13 Twp. 20 R. 11W.

Well No. 1 M. Meyer

Gulf Company

Contractor

SECTION PLAT

		0	

 Ft. from N. Line

330 Ft. from S. Line

 Ft. from E. Line

330 Ft. from W. Line

FIRST REPORT

Location

Rig up

Drilling and Remarks:

Rigging up.

RECORD

Cased in., ft.

Sand

Gas

Oil

Total Depth

PRODUCTION

1st 24 hrs. Nat.

1st 24 hrs. after shot

Gas Cu. Ft.

Dry Hole

Abandoned

Date

DEC 16 1936

19

S. J. LEWIS

Scout

Barton KANSASMap No. _____ Sec. 13 Twp. 20 R. 11 ^WWell No. 1 - MeyerGulf Company

Contractor _____

COMPLETED

1320 Ft. from N. Line330 Ft. from S. Line

_____ Ft. from E. Line

330 Ft. from W. Line

SECTION PLAT

		0	

Location _____

Rig up _____

Drilling and Remarks:

*Minimum well**15 bbls per day*

RECORD

Cased 7 in., 3262 ft.Sand 511 3261

Gas _____

Oil _____

Total Depth 3335

PRODUCTION

1st 24 hrs. Nat. _____

1st 24 hrs. after shot _____

Gas _____ Cu. Ft.

Dry Hole _____

Abandoned _____

Date

JUL 14 1937

19

H. D. Hatfield

Scout