

KANSAS

Barton

FORM 51 IOM 12-46 PETROL

Section 13 Township 20 Range 11-W

Well No. 4 Peters


Company Mouser Drlg.

Silica Pool

NORTH

WEST

EAST

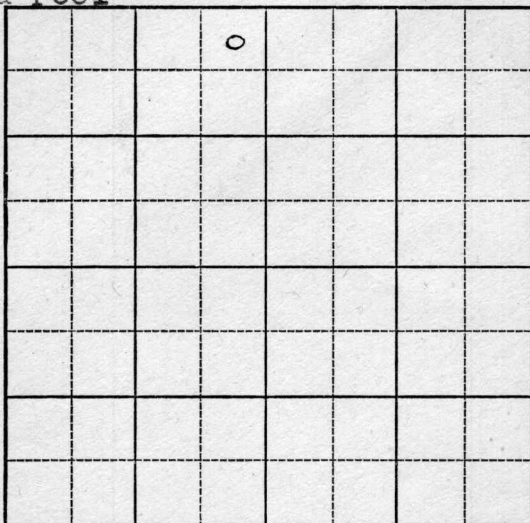

SOUTH

KANSAS

Barton

Sec. 13 Twp. 20 R. 11W

Well No. 4 Peters Farm

Mouser Drlg. Company

Silica Pool


330 Ft. from N. Line

 Ft. from S. Line

330 Ft. from E. Line

 Ft. from W. Line

NE NW

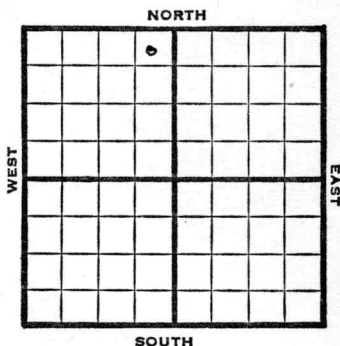

1947	Elev. 1751	REPORT
8/13	RUR	
8/20	"	
8/27	8" @ 112'	
	Drlg. 3035'	
9/3	Lansing 3023	
	Arbuckle 3269-70	
	TD 5" @ 3270, Rust	
9/10	TD 3274-2000 acid	1200' oil 24 hrs.
9/17	"	"
9/24	"	"
10/1	Arbuckle 3269	
	5" @ 3270	
	2000 acid	
	Pump 200 Pot	
	TD 3274	
	Gravity 42	

COMPLETED

Map No. _____ Sec. 13 Twp. 20 R. 11W

Well No. 4 Peters

Mouser Drlg. Company

FIRST REPORT Contractor

NE NW


SECTION PLAT

330 Ft. from N. Line

_____ Ft. from S. Line

330 Ft. from E. Line

_____ Ft. from W. Line

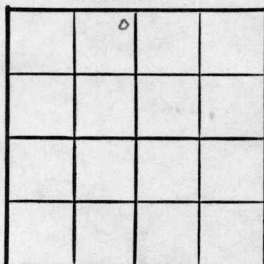

Barton County

Location _____

Rig up _____

Drilling and Remarks:

R U R

RECORD

Cased _____ in., _____ ft.

Sand _____

Gas _____

Oil _____

Total Depth _____

PRODUCTION

1st 24 hrs. Nat. _____

1st 24 hrs. after shot _____

Gas _____ Cu. Ft.

Dry Hole _____

Abandoned _____

Date

AUG 13 1947 19

S. J. LEWIS Scout

Map No. 46 Sec. 13 Twp. 20 R. 11W

Well No. 4 Peters

Mouser Drlg. Company

COMPLETE

Contractor

NE NW


E 1/2
SECTION PLAT

330 Ft. from N. Line

 Ft. from S. Line

330 Ft. from E. Line

 Ft. from W. Line

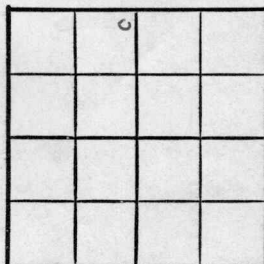

Barton County

Location

Rig up

Drilling and Remarks:

CR 43269
5" 63270
2000 ac. oil
Pump 200 BT

42 1/2

RECORD

Cased in., ft.

Sand

Gas

Oil

Total Depth 8274

PRODUCTION

1st 24 hrs. Nat.

1st 24 hrs. after shot

Gas Cu. Ft.

Dry Hole

Abandoned

Date

OCT 1 1947 19

S. J. LEWIS Scout