

Section 13 Township 20 Range 11W

Well No. 7 Peters

Company N C R A

Silica Pool

NORTH

							0

WEST

EAST

SOUTH

KANSAS

Barton

Sec. 13 Twp. 20 R. 11W

Well No. 7 Peters Farm

N C R A

Company


Silica Pool

 Ft. from N. Line

990 Ft. from S. Line

330 Ft. from E. Line

 Ft. from W. Line

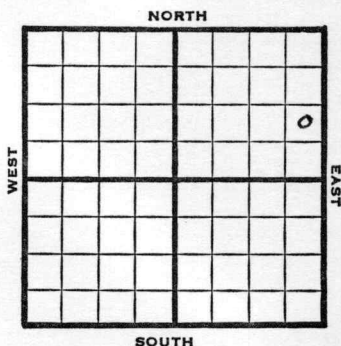

NE SE NE

1948

Eli 1752'

REPORT

9/22

8" @ 160'

9/29

Drlg 2800'

10/6

Arb 3283-85'

TD 3285'

5" @ 3284'

10/13

"

10/20

TD 3295'

Arb. 3283'

5" @ 3284'

1000 acid

Pump 45 oil Pot

42° Gr.

Comp

COMPLETED

Barton County Kansas StateMap No. _____ Sec. 13 Twp. 20 R. 11WWell No. 7 PetersN C R A CompanyFIRST REPORT Contractor

NE SE NE

SECTION PLAT

_____ Ft. from N. Line

990 Ft. from S. Line330 Ft. from E. Line

_____ Ft. from W. Line

Silica Pool

Remarks:

8" @ 160

Date
SEP 22 1948Scout
S. J. LEWIS

