


Section 13 Township 20 Range 11W

Well No. #12 Peters

Company National Cooperative Refinery Assn.

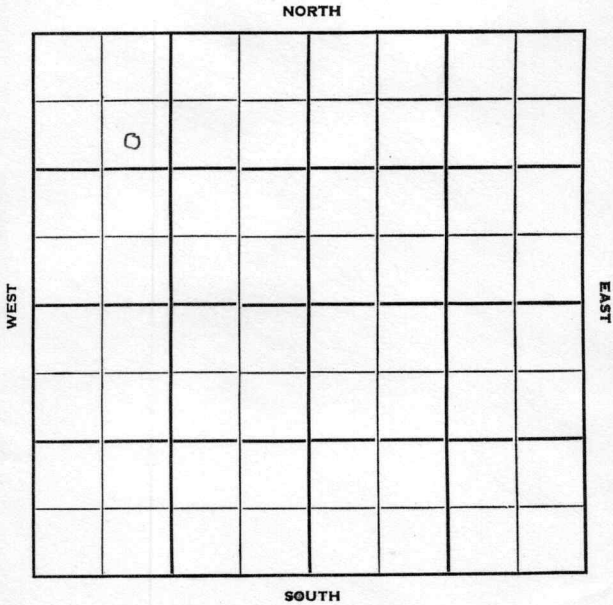

Barton

KANSAS

Sec. 13 Twp. 20 R. 11W

Well No. #12 Peters Farm

National Cooperative Ref. Assn. Company

Quaker - Contr. Contractor

Silica Pool


990' Ft. from N. Line

 Ft. from S. Line

 Ft. from E. Line

990' Ft. from W. Line

SE NW NW

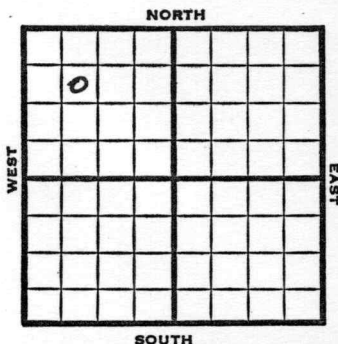

1951 Elev. 1750' REPORT

9/19 Spud 9-17-51
Drlg.

10/24 Spud 9-17-51
D&A TD 3315
8" @ 164
Br. lm. 2988 Lans. 3009
Arb. 3265
TD 3270
5" @ 3268 DD 3278 500 A
B/ 2 GO 5½ GWPB DD 3281
PB 3260 1750 A B/ 56 GO
76 GW 15 hr. 1000 A No inc.
500 A wtr. DD 3315
D&A

ABANDONED

County Barton State KansasSec. 13 (Blk.) 20 (Sur.) 11W Map No.Operator National Cooperative Refinery Assn.Well No. 12 Farm PetersElev. Location SE NW NW

	0						

990 Ft. From N Line NW990 Ft. From W Line Quarter1st. Report SEP 19 1951

Completion

Remarks

Quaker - Contr.Spudding Date 9-17-51Drlg. Data Silica - poolDrlg.

County Barton State Kansas
 Sec. 13 (Blk.) 20 (Sur.) 11W Map No.
 Operator National Coop Ref. Assn.
 Well No. 12 Farm Peters
 Elev. 1750 Location SE NW NW

0							

990 Ft. From N Line NW
990 Ft. From W Line Quarter

1st. Report

Completion OCT 24 1951

Remarks Silica Pool

Quaker Drlg. - Contr.

Spudding Date 9-17-51

Drlg. Data D & A TD 3315

8" @ 164 Br. lime 2988 Lans. 3009

Arb. 3265 TD 3270 5" @ 3268 DD 3278

500 A B/ 2 go 5 $\frac{1}{2}$ gwph DD 3281

PB 3260 1750 A B/ 56 go 76 gw 15 hr.

1000 A no inc. 500 A water DD 3315

D & A

J. E. TYRA