


FORM 51

Section 32 Township 18 Range 11W
Well No. #10 Robl
Company Shelly-Miller Drlg.

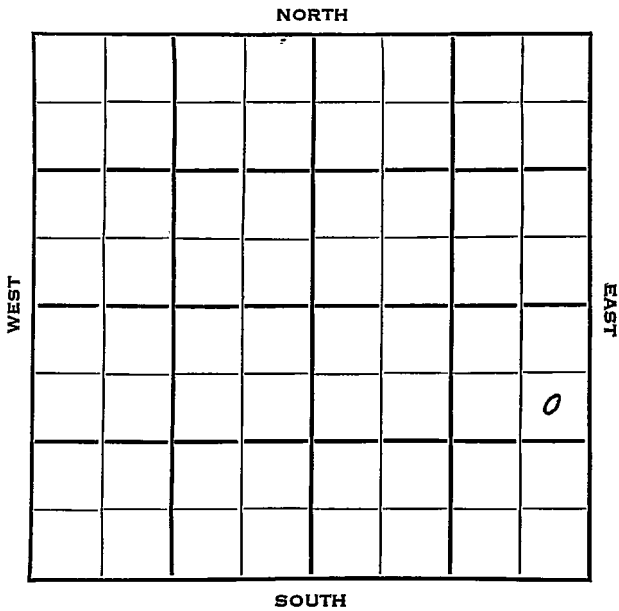

Barton

KANSAS

SEC.	TWP.	R.
32	18	11W ✓

WELL NO.

#10 Robl

FARM

COMPANY

Shelly-Miller Drlg.

CONTRACTOR

Shelly Miller

Bieberle Pool

NORTH

990

Ft. from N. Line

Ft. from S. Line


330

Ft. from E. Line

Ft. from W. Line

WEST

EAST

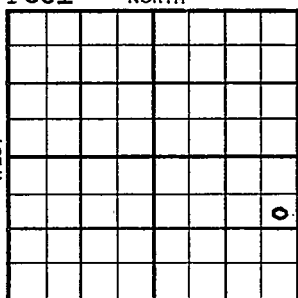

SOUTH

SE NE SE

	ELEVATION	REPORT
1954	1826'	
2/10	Spud 2-6-54 8" @ 153' Drlg 1885'	
2/17	Heeb 2958', Br li 3077', Lans 3091' DST 3110-75', 1 hr., 2900' oil, 775# Cong 3359', Arb. 3397' RTD 3400' Schl 5" @ 3398'	
2/24	CO 3364', 20/3150-57, 3000A F 39 BO 50 mins.	
3/3	NR	
3/10	Spud 2-6-54 Oil Well TD 3400' 8" @ 153' Heeb 2958', Br lime 3077', Lans 3091' DST 3110-75', opn 1 hr., rec. 2900' oil, 775# Cong 3359', Arb. 3397' TD 3400' 5" @ 3398' CO to 3364', 20/3150-57, 3000A F 39 bo 50" Comp. BHB 1062 BOPD	

COMPLETED

County **Barton** State **Kansas**

Sec. 32 (Blk.) 18 (Sur.) 11W Map No.

Operator **Shelly-Miller Drlg.**

Well No. 10 Farm Robt

Elev.	1826	Location	SE NE SE
-------	------	----------	----------

FIRST REPORT

990 Ft. From N Line SE

330 Ft. From E Line Quarter

1st. Report FEB 10 1954

Completion


Remarks

Shelly-Miller - Contr.

Spudding Date **2-6-54**

Drlg. Data Bieberle Pool

8" @.153 drlg. 1885

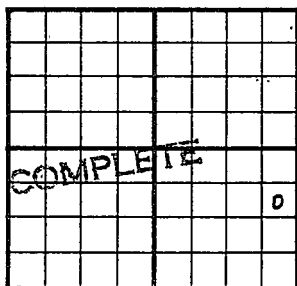County Barton State KansasSec. 32 (Blk.) 18 (Sur.) 11W Map No.Operator Shelly-Miller Drlg.Well No. 10 Farm RoblElev. 1826 Location SE NE SE990 Ft. From N Line SE330 Ft. From E Line Quarter

1st. Report

Completion MAR 10 1954Remarks Bieberle PoolShelly-Miller - Contr.Spudding Date 2-6-54Drlg. Data Oil well TD 34008" @ 153 Heeb. 2958 Br. lime 3077Lans. 3091. DST 3110-85 open 1 hr.Rec. 2900' oil 775 $\frac{11}{16}$ Cong. 3359Arb. 3397 TD 3400 5" @ 3398CO to 3364 20/ 3150-57 3000 AF/ 39 bo 50 min. Comp. EHB 1062 bopd

J. G. McGEHEE