


Section 32 Township 18 Range 11W

Well No. #11 Rob1

Company Shelly-Miller

NORTH

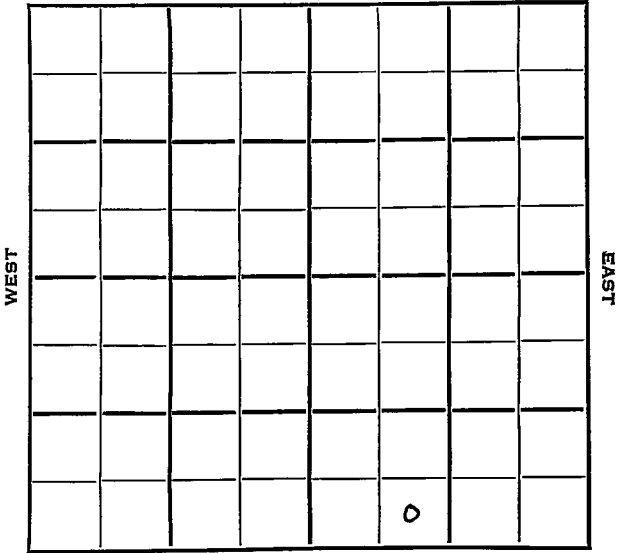

SOUTH





