


Section 32 Township 18 Range 11W

Well No. #5 Schlochtermeyer

Company Texas Company

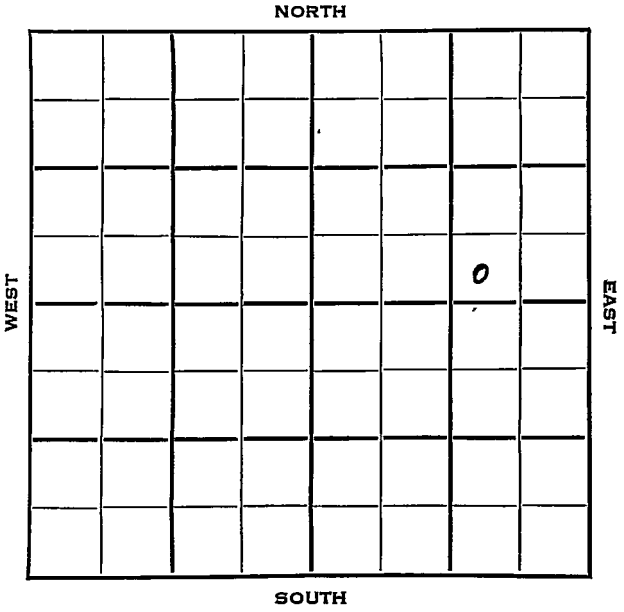

Barton KANSAS


SEC.	TWP.	R.
32	18	11W

WELL NO. 5 Schlochtermeyer FARM

COMPANY Texas Company

CONTRACTOR Braden Drlg. Bieberle Pool

_____ Ft. from N. Line
 330 _____ Ft. from S. Line
 990 _____ Ft. from E. Line
 _____ Ft. from W. Line

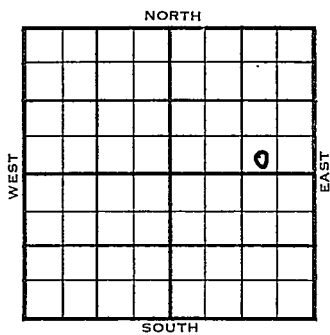

SW SE NE

	ELEVATION	REPORT
1954	1828'	
3/3		Spud 2-25-54 10" @ 640' Drlg. 1735'
3/10		Br li 3065', Lans 3082'
3/17		Arb. 3386' RTD 3411' 7" @ 3410'
3/24		CO 3411', SO DD 3413', FU 800' oil 3 hrs. S/4 1/2 boph 8 hrs. PB 3345', 18/3252-58' 5 1/2 go + 7 1/2 gwph 3 hrs., 2000A F 72 BO 1 hrs. F 46 BO 1 hrs., 1/2" ck
3/31		Spud 2-25-54 Oil Well TD 3413' 10" @ 640' Br. Lime 3065', Lans 3082'. Arb 3386' TD 3411' 7" @ 3410' CO to 3411' DD 3413' FU 800' oil 3 hr.

OVER

1954

Information brought forward.

3/31^{1/2} S/ $4\frac{1}{2}$ boph 8 hr.

PB 3345'

18/ 3252-58 $7\frac{1}{2}$ go $7\frac{1}{2}$ gwph 3 hr.

2000 A

F/ 72 bo 1 hr.

F 46 bo 1 hr.

Comp 3000 bopd.

COMPLETED

