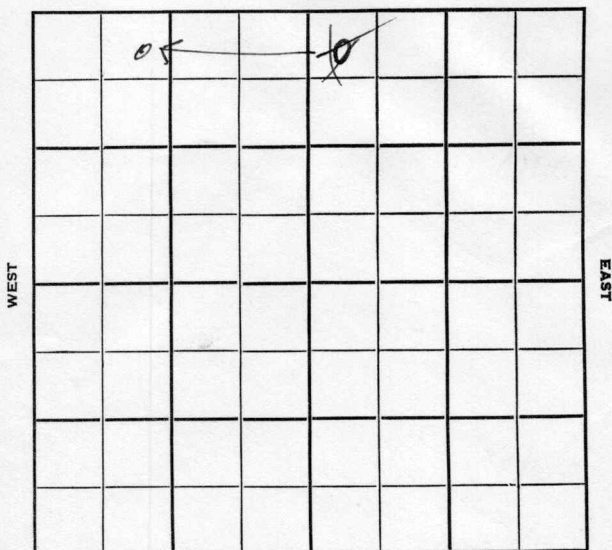


Section 14 Township 20 Range 11 WWell No. # 6 Burchard (*Burchard*)Company Mouser Drlg.

NORTH



SOUTH

Barton

KANSAS

Sec. 14 Twp. 20 R. 11 WWell No. # 6 Burchard FarmMouser Drlg. Company

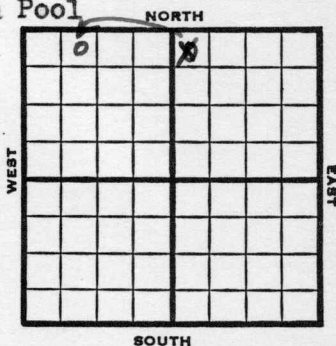
Contractor

Chase-Silica Pool

330 Ft. from N. Line

Ft. from S. Line

Ft. from E. Line

990330 Ft. from W. LineNE NWNW
NW NW NE

1953 Elev. 1759'

REPORT

6/17 Location

7/8 "

7/22 Spud 7-7-53

D&A

TD 3325

8" @ 188

Anhy 500, Heeb 2886, Lans 3031, Cong
3286, Arb. 3294DST 3286-99, opn 1 hr., rec. 60' gas,
30' oily gcm, 100#DST 3299-3311, opn 1 hr., rec. 12' mud,
O#

TD 3325

D&A

ABANDONED

County Barton State KansasSec. 14 (Blk. Twp.) 20 (Sur. Rge.) 11W Map No.Operator Mouser Drlg.Well No. 6 Farm BurchardElev. Location NW NW NE

330 Ft. From N Line NE330 Ft. From W Line Quarter1st. Report JUN 17 1953

Completion

Remarks

Spudding Date

Drlg. Data Chase-Silica PoolLocation

J. G. McGEHEE

Barton

Kansas

Map No. _____ Sec. 14 Twp. 20 R. 11WWell No. 6 Burchard_____Mouser Drlg._____ Company_____
Contractor

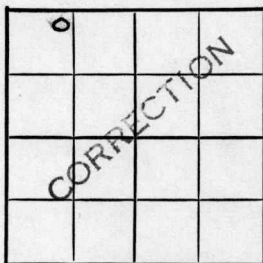
NE NW NW

SECTION PLAT

330 Ft. from N. Line

_____ Ft. from S. Line

_____ Ft. from E. Line

990 Ft. from W. Line

Location _____

Rig up _____

Drilling and Remarks:

Reported

NW NW NE

RECORD

Cased _____ in., _____ ft.

Sand _____

Gas _____

Oil _____

Total Depth _____

PRODUCTION

1st 24 hrs. Nat. _____

1st 24 hrs. after shot _____

Gas _____ Cu. Ft.

Dry Hole _____

Abandoned _____

Date

JUL 8 1952

J. G. McGEHEE

19

Scout

County Barton State Kansas
 Sec. 14 (Blk. 20) (Sur. 11W) (Rge.) Map No.
 Operator Mouser Drlg.
 Well No. 6 Farm Burchard
 Elev. 1759 Location NE NW NW

0						

330 Ft. From N Line NW
990 Ft. From W Line Quarter

1st. Report

Completion JUL 22 1953

Remarks Chase-Silica Pool

Spudding Date 7-7-53

Drlg. Data D & A TD 3325

8" @ 188 Anhy 500 Heeb. 2886

Lans. 3031 Cong. 3286 Arb. 3294

DST 3286-99 open 1 hr. Rec. 60' gas

30' oily gcm 100# DST 3299-3311

open 1 hr. Rec. 12' mud 0# TD 3325

D & A

J. G. McGEE