


DX 78-1 Barton

KANSAS

Section 32 Township 18 Range 11W

Well No. #6 Schlochtermeyer

Company Texas Company

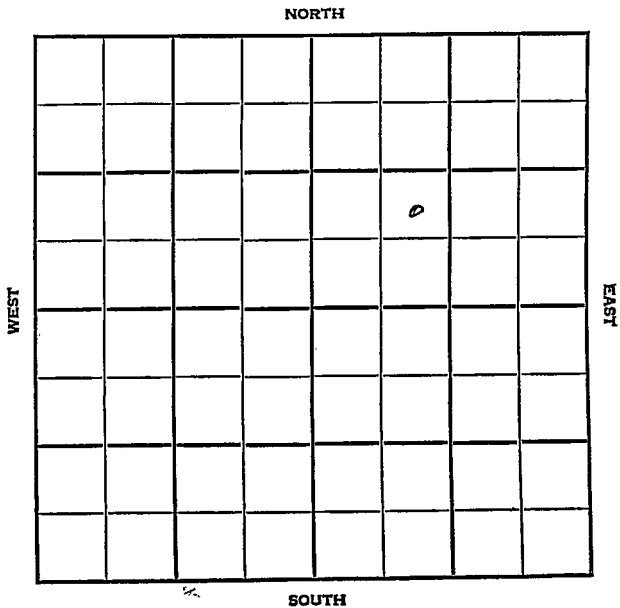

Barton KANSAS

SEC.	TWP.	R.
32	18	11W

WELL NO.

6 Schlochtermeyer

FARM

COMPANY

Texas Co.

CONTRACTOR

Noble Drlg. Co.
Bieberle Pool

Ft. from N. Line

990


Ft. from S. Line

Ft. from E. Line

990

Ft. from W. Line

NE SW NE

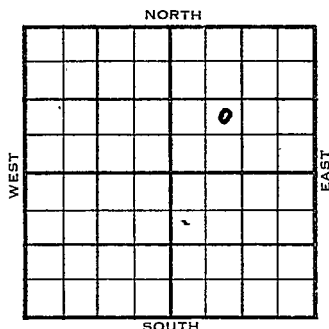

1954

ELEVATION

1840'

REPORT

Arb. Test

11/17

Location

12/15

Spud 11-21-54

Oil Well

TD 3441'

10" @ 661'

Heeb 2977', Br. Line 3093' Lans 3108'

Arb. 3430'

TD 3435'

7" @ 3434'

DD3441' S/ $\frac{1}{2}$ go 2 gwph 2 hr.

500 A

S/ 17 bo 7 bw. 4 hr.

Comp 139 bopd. 28% Wtn

COMPLETED

County **Barton** State **Kansas**

Sec. **32** (Blk. **18** (Sur. **11W** Map No.

Operator Texas Company

Well No. 6 Farm Schlochtermeyer

Elev.	Location	NE	SW	NE
-------	----------	----	----	----

FIRST REPORT

990 Ft. From S Line NE

990 Ft. From ~~W~~ Line Quarter

1st. Report NOV 17 1954

Completion

Remarks **Arb. test**

Spudding Date

Drlg. Data Bieberle Pool

Location

FABEN GILSTRAD

Sec. 32 (Blk. Twp.) 18 (Sur. Rge.) 11W Map No.

Operator Texas Company

Well No. 6 Farm Schlochtermeyer

Elev.	1840	Location	NE SW NE
-------	------	----------	----------

COMPLETED

990 Ft. From S Line NE

990 Ft. From W Line Quarter

1st. Report

Completion DEC 15 1954

Remarks Bieberle Pool

Noble Drlg. - Contr.

Spudding Date 11-21-54

Drig. Data Oil well TD 3441

10" @ 661 Heeb. 2977 Br. lime 3093

Lans. 3108 Arb. 3430 TD 3435 7" @ 3434

DD 3441 S/ $\frac{1}{2}$ go 2 gwph 2 hr. 500 A

S/ 17 bo 7 bw 4 hr.

Comp. 139 bopd 18% wtr.

FABEN GILSTRAE