


Section 13 Township 20 Range 11W

Well No. 11 Peters

Company N C R A

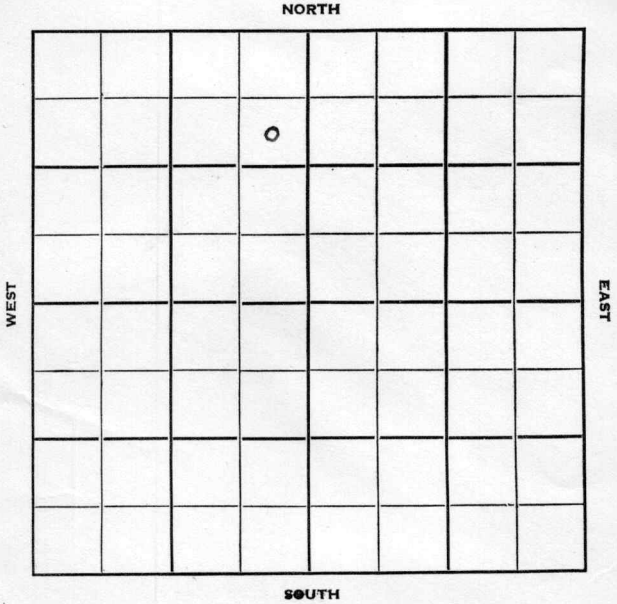

Sec. 13 Twp. 20 R. 11W ✓

Well No. #11 Peters Farm

NCRA Company

Braden Drlg. - Contr. Contractor


990' Ft. from N. Line

\_\_\_\_\_ Ft. from S. Line

330' Ft. from E. Line

\_\_\_\_\_ Ft. from W. Line

SE NE NW

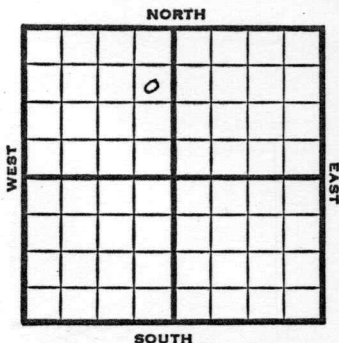

1951 Elev. 1753' REPORT

8/1 Spud 7-20-51  
8" @ 151  
Anhy 1200  
Heeb. 2861  
Lans. 3020  
Arb. 3266-67 TD  
5" @ 3267

9/5 Spud 7-20-51  
Oil Well TD 3270  
8" @ 151  
Anhy 1200  
Heeb. 2861  
Lans. 3020  
Arb. 3266-67  
5" @ 3267  
TD 3270 1 boph 500 A P/7 boph 3 hr.  
P/44 bo 6 hr Comp. 176 bopd

**COMPLETED**

County Barton State Kansas

Sec. 13 (Blk. Twp.) 20 (Sur. Rge.) 11W Map No.

Operator N C R A

Well No. 11 Farm Peters

Elev. 1756 Location SE NE NW

		0		
<b>FIRST REPORT</b>				

990 Ft. From N Line NW

330 Ft. From E Line Quarter

1st. Report AUG 1 1951

Completion \_\_\_\_\_

Remarks \_\_\_\_\_

Braden Drlg. - Contr.

Spudding Date 7-20-51

Drlg. Data \_\_\_\_\_

8" @ 151 Anhy 1200 Heeb. 2861 Lans. 3020

Arb. 3266-67 TD 5" @ 3267

J. E. TYRA

County Barton State Kansas

Sec. 13 (Blk. 20) (Sur. 11W) (Twp.) Map No.

Operator N C R A

Well No. 11 Farm Peters

Elev. 1753 Location SE NE NW

		0			

990 Ft. From N Line NW

330 Ft. From E Line Quarter

Ist. Report

Completion SEP 5 1951

Remarks

Braden Drlg. - Contr.

Spudding Date 7-20-51

Drlg. Data Oil well TD 3270

8" @ 151 Anhy 1200 Heeb. 2861

Lans. 3020 Arb. 3266-67 5" @ 3267

TD 3270 1 boph 500 A P/ 7 boph 3 hr.

P/ 44 bo 6 hr. Comp. 176 bopd