


Section 13 Township 20 Range 11 W

Well No. # 14 Peters

Company NCRA

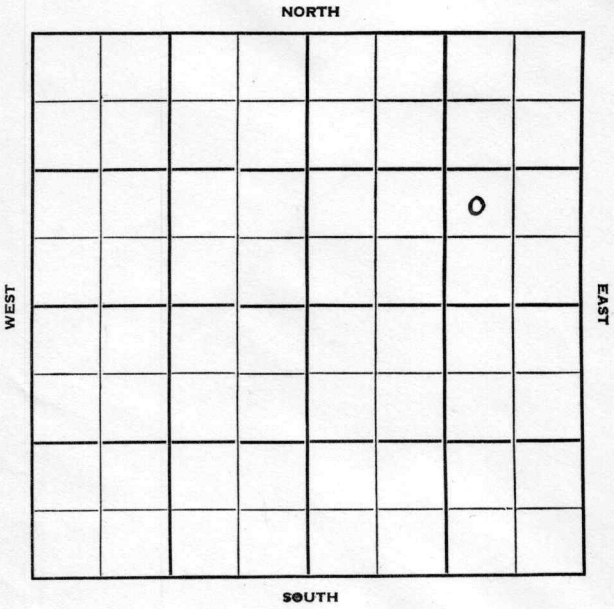

Sec. 13 Twp. 20 R. 11W

Well No. #14 Peters Farm \_\_\_\_\_

N C R A Company \_\_\_\_\_

Contractor \_\_\_\_\_


\_\_\_\_\_ Ft. from N. Line

990 Ft. from S. Line

990 Ft. from E. Line

\_\_\_\_\_ Ft. from W. Line

NW SE NE

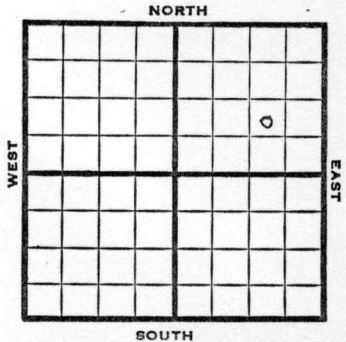

1952

Elev. 1751' REPORT

2/20

Spud 2-14-52  
8" @ 152'  
Drlg. 2130'

3/5

DD 3295 500 A S/9 BO 7 hrs.  
B 44 gal oil & 13 gal wtr 2 hrs.

3/11

Hyd fill up 110' oil 190' wtr 19 hrs.  
S/ 14 BF 5 hrs. Est 52% wtr POP

3/19

Spud 2-14-52  
Oil Well TD 3295  
8" @ 152 Heeb. 2867  
Br Lime 2991 Lans. 3008  
Cong. 3284 Arb. 3290  
DST 3291-93 opn 2 hr. Rec. 8' mud  
TD 3293 5" @ 3291 DD 3295 500 A  
S/9 bo 7 hr. B/44 go 3 gw 2 hr.  
Hydra FU 170' oil 190' wtr 19 hr,  
S/14 bf 5 hr. Comp. 60 bfpd 40% wtr.

**COMPLETED**

County **Barton** State **Kansas**

Sec. **13** (Blk. Twp.) **20** (Sur. Rge.) **11W** Map No.

Operator **N C R A**

Well No. **14** Farm **Peters**

Elev. Location **NW SE NE**


FIRST REPORT

**990** Ft. From **S** Line **NE**

**990** Ft. From **E** Line Quarter

1st. Report **FEB 20 1952**

Completion

Remarks

Spudding Date **2-14-52**

Drlg. Data

**8" @ 152 & lg. 2130**

J. G. McGEHEE

