

Barton

FORM 51


KANSAS

Section 32 Township 18 Range 11W

Well No. #9 Robl

Company Shelly-Miller

NORTH

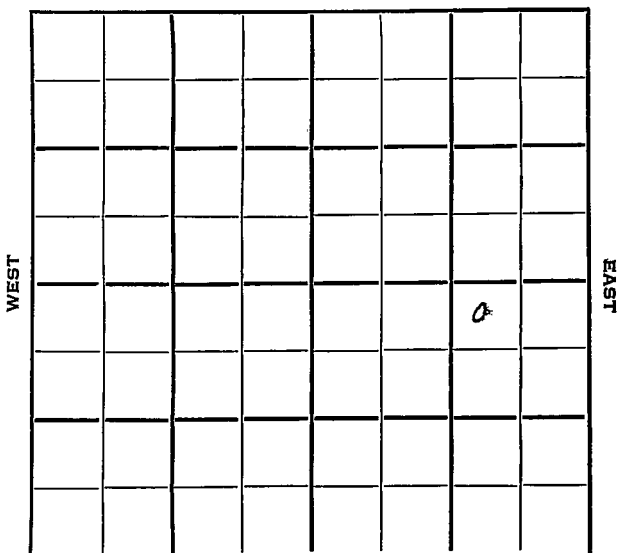

SOUTH

Barton

SEC.	TWP.	R.	KANSAS
32	18	11W	✓

WELL NO.

#9 Robl

FARM

COMPANY

Shelly-Miller

CONTRACTOR

Shelly-Miller


Bieberle Pool

330 Ft. from N. Line

Ft. from S. Line

990 Ft. from E. Line

Ft. from W. Line

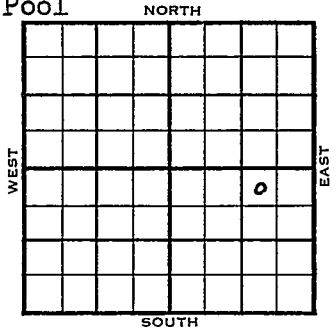

NW NE SE

	ELEVATION	REPORT
1954	1830'	
1/27	R U R	
<del>1/27</del> 2/3	8" @ 158' Anhy 635' Drlg. 2900'	
2/10	Heeb 2953' Br li 3069' Lans 3086 DST 3100-60, 3/4 hr, F/OCM in 43 mins. FHO & M Cong. 3362' Arb. 3371' RTD 3390 Schl 5" @ 3387	
2/17	20/3151-57, 3000A F 95 bo 50 mins.	
2/24	Spud 1-26-54 Oil well TD 3390 8" @ 158 Anhy 635 Heeb 2953' Br. lime 3069 Lans 3086 DST 3100-60 open 3/4 hr F/OCM in 43 min. HFO & mud. Cong. 3362 Arb. 3371 TD 3390 5" @ 3387 20/3151- 57 3000 A F/95 BO 50 min. Comp. 3000 BOPD	

**COMPLETED**



County Barton State Kansas

Sec. 32 (Blk. 18) (Sur. 11W) (Twp. 18) (Rge. 11W) Map No.

Operator Shelly-Miller

Well No. 9 Farm Robl

Elev. 1830 Location NW NE SE

<b>COMPLETE</b>							

330 Ft. From N Line SE

990 Ft. From E Line Quarter

1st. Report FEB 24 1954

Completion FEB 24 1954

Remarks Bieberle Pool

Shelly-Miller - Contr.

Spudding Date 1-26-54

Drlg. Data Oil well TD 3390

8" @ 158 Anhy 635 Heeb. 2953

Br. lime 3069 Lans. 3086 DST 3100-60

opne 3/4 hr. F. ocm in 43 min.

HFO & mud Cong. 3362 Arb. 3371

. TD 3390 5" @ 3387 20/ 3151-57

3000 A F/ 95 bo 50 min.

Comp. 3000 bopd