

# KANSAS

FORM 51 10M 2-49 PETROL

Barton

Section 14 Township 20 Range 11W

Well No. 2 Burchart

Company Mouser Drlg.

Silica

NORTH

							0

WEST

EAST

SOUTH

Barton

KANSAS ✓

Sec. 14 Twp. 20 R. 11W

Well No. #2 Burchart Farm \_\_\_\_\_

Mouser Drlg. Company \_\_\_\_\_


Silica Pool (Mouser Drlg., Cont.) NORTH

990' Ft. from N. Line

\_\_\_\_\_ Ft. from S. Line

330' Ft. from E. Line

\_\_\_\_\_ Ft. from W. Line

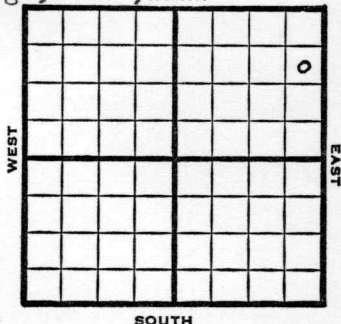

SE NE NE

1949 Elev. 1755' REPORT

7/20 8" @ 225'

7/27  
Lans. 3028'  
Cong. 3300'  
Arb. 3302'  
TD 3310'

**ABANDONED**

Map No. \_\_\_\_\_ Sec. 14 Twp. 20 R. 11W

Well No. 2 Burchart

Mouser Drlg. \_\_\_\_\_ Company

Mouser Drlg. \_\_\_\_\_ Contractor

SE NE NE

FIRST REPORT  
SECTION PLAT

990 Ft. from N. Line

\_\_\_\_\_ Ft. from S. Line

330 Ft. from E. Line

\_\_\_\_\_ Ft. from W. Line

			o

Barton County

Location \_\_\_\_\_

Rig up \_\_\_\_\_

Drilling and Remarks:

8" @ 225

RECORD

Cased \_\_\_\_\_ in., \_\_\_\_\_ ft.

Sand \_\_\_\_\_

Gas \_\_\_\_\_

Oil \_\_\_\_\_

Total Depth \_\_\_\_\_

PRODUCTION

1st 24 hrs. Nat. \_\_\_\_\_

1st 24 hrs. after shot \_\_\_\_\_

Gas \_\_\_\_\_ Cu. Ft.

Dry Hole \_\_\_\_\_

Abandoned \_\_\_\_\_

Date

JUL 20 1949 19

S. J. LEWIS Scout

Silica Pool

Map No. K46 Sec. 14 Twp. 20 R. 11W

Well No. 2 Burchart

Mouser Drlg. Company

**ABANDONED** Contractor

SE NE NE

*E 11765*

SECTION PLAT

990 Ft. from N. Line

\_\_\_\_\_ Ft. from S. Line

330 Ft. from E. Line

\_\_\_\_\_ Ft. from W. Line

			0

Barton County

Location \_\_\_\_\_

Rig up \_\_\_\_\_

Drilling and Remarks:

*Same 3025  
Comp 3300  
C 9302*

RECORD

Cased \_\_\_\_\_ in., \_\_\_\_\_ ft.

Sand \_\_\_\_\_

Gas \_\_\_\_\_

Oil \_\_\_\_\_

Total Depth 3310

PRODUCTION

1st 24 hrs. Nat. \_\_\_\_\_

1st 24 hrs. after shot \_\_\_\_\_

Gas \_\_\_\_\_ Cu. Ft.

Dry Hole \_\_\_\_\_

Abandoned \_\_\_\_\_

Date

JUL 27 1949 19

S. J. LEWIS

Scout