


Section 14 Township 20 Range 11-W


Well No. #4 Burchart

Company I.T.I.O.

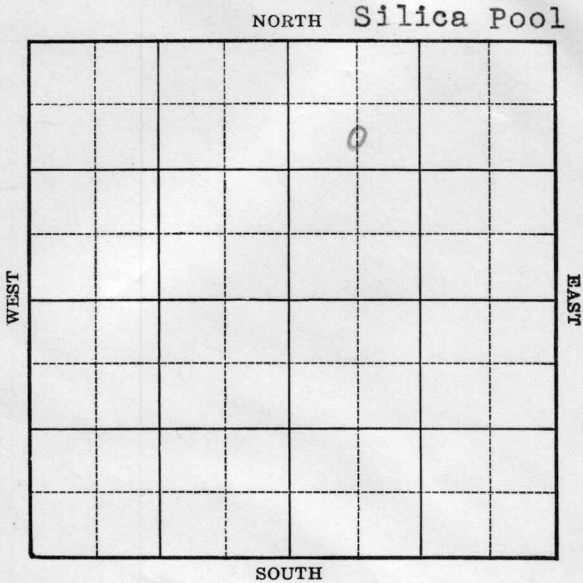

Company

660 Ft. from W. Line

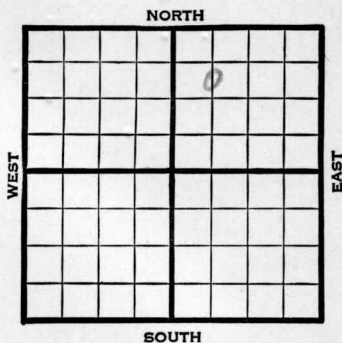

1940	REPORT
10/23	Derrick.
10/31	10" - 194' Drlg. 1375'
11/7	Drlg. 3086'
11/14	Arb. ~~3290~~ ³²⁸⁷ 7" - 3291'
	T.D. 3307' RUST.
11/21	Arb. 3288' (Corrected)
	7" - 3291' T.D. 3307' 1000
	acid. C.O.
11/27	T.D. 3333' S.W.
	P.B. 3311'
12/5	10 qts. C.O. 2000 acid.
	Swab 4 bbls. a day. P.B.
12/12	" " " "
	OVER

1940
12/18

Arb. 3288'
7" - 3291'
T.D. 3333'
Shot 10 qts.
5250 acid.
Water.

ABANDONED

Map No. 46 Sec. 14 Twp. 20 R. 11WWell No. 4 Burchart

I T I O

Company

Contractor

FIRST REPORT

SECTION PLAT

990 C S L NW NE
Ft. from N. Line

Ft. from S. Line

Ft. from E. Line

660 Ft. from W. Line

SILICA POOL

Location

Rig up

Drilling and Remarks:

Derri ck

RECORD

Cased _____ in., _____ ft.

Sand _____

Gas _____

Oil _____

Total Depth _____

PRODUCTION

1st 24 hrs. Nat. _____

1st 24 hrs. after shot _____

Gas _____ Cu. Ft.

Dry Hole _____

Abandoned _____

Date

OCT 23 1940 19S. J. LEWIS Scout

Map No. 46 Sec. 14 Twp. 20 R. 11WWell No. 4 Burchart

I T I O

Company

Contractor

ABANDONED

C S L NW NE

990 Ft. from N. Line Ft. from S. Line Ft. from E. Line660 Ft. from W. Line

SILICA POOL

SECTION PLAT

Location Rig up

Drilling and Remarks:

*Ar 83288**7" @ 3291'**10 ft.**5200 acrid**Water.*

RECORD

Cased in., ft.Sand Gas Oil Total Depth 3333

PRODUCTION

1st 24 hrs. Nat. 1st 24 hrs. after shot Gas Cu. Ft.Dry Hole Abandoned

Date

DEC 18 1940 19

S. J. LEWIS

Scout