


Map No. KANSAS Sec. 14 Twp. 20 R. 11W
 Well No. 1- Langfeld Farm
Buchanan & Alexander Company

NORTH

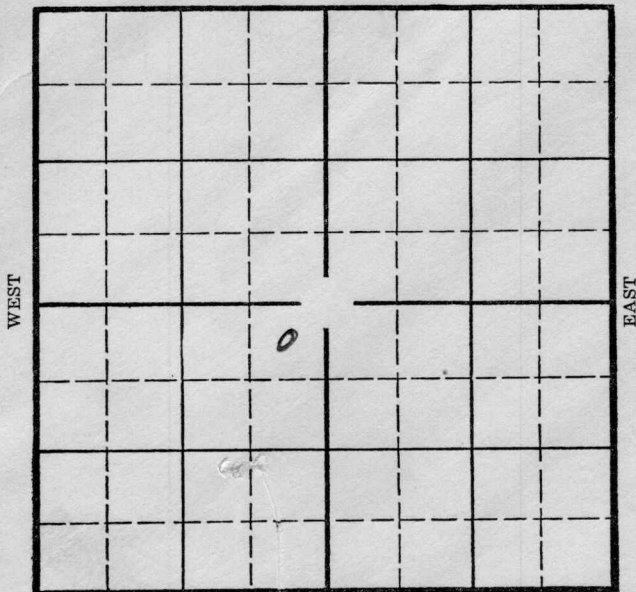

SOUTH

Location _____
 Drilling Remarks _____

Rig Up _____
 Drilling Remarks _____

RECORD

Cased _____ in. _____ ft.
 Sand _____
 Gas _____
 Oil _____
 Total Depth _____

PRODUCTION

1st 24 hrs. Nat. _____
 1st 24 hrs. after shot _____
 Gas _____ cu. ft. _____
 Dry Hole _____
 Abandoned _____

Barton


Well No. 1- Langfield Farm

Buchanan & Alexander Company


330 Ft. from N. Line

330 Ft. from S. Line

330 Ft. from E. Line

330 Ft. from W. Line

Elev. 1759

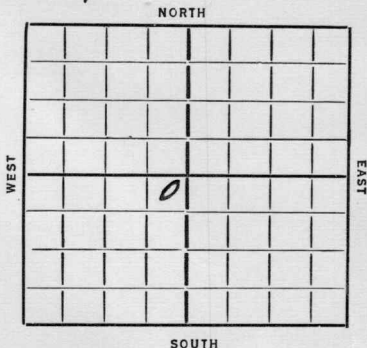

REPORT

Date	Report
1/2/11	Cellar & Pits
12/19	— 12/26 — 1/2/36 —
1/10	Cable Rig
1/17	Rgn up
1/24	28" 18" 15" 94
1/31	Wlg. 548 12" 540
2/7	" 1950
2/14	" 1875
2/21	T.D. 2030 S.D.
2/28	— 3/6 — 3/13 —
3/20	10"-1940 Drlg. 2245
3/27	T.D. 2240' Repair rig.
4/2	T.D. 2270' Waiting on pipe.
4/10	2305-8" Drlg. 2395'
4/16	Drlg. 2915'
4/27	Top Siliceous 3283
	T.D. 3289 Hole full oil (Tel)
5/7	Swab 15 bbls per hour. 1000 acid.
5/14	Drilled to 3299½'. T.D. increase in oil.
5/21	Potential 488 bbls.

(OVER)

5/27/36-Sil. 3282'.

4000 gallons acid.

T.D. 3299 $\frac{1}{2}$ '

Pot. 1110 bbls in 20 hours.

COMPLETED

Map No. *46* Sec. *14* Twp. *20* R. *11 W*

Well No. *1 - Langfeld*

Buchanan + Alexander Company

Contractor

FIRST REPORTS

SECTION PLAT

	0		

330 Ft. from N. Line

..... Ft. from S. Line

330 Ft. from E. Line

..... Ft. from W. Line

Location.....

Rig up.....

Drilling and Remarks:

Cellar + Pits

RECORD

Cased.....in., ...ft.

Sand.....

Gas.....

Oil.....

Total Depth.....

PRODUCTION

1st 24 hrs. Nat.....

1st 24 hrs. after shot.....

Gas.....Cu. Ft.

Dry Hole.....

Abandoned.....

Date

12-11-35 192..... Scout

ORVAL MANNSCHRECK

KANSAS

Map No. 46 Sec. 14 Twp. 20 R. 11WWell No. 1 Lang 266Buchanan & Alexander Company

Contractor

SECTION PLAT

	0		

330 Ft. from N. Line

_____ Ft. from S. Line

330 Ft. from E. Line

_____ Ft. from W. Line

COMPLETED

Location _____

Rig up _____

Drilling and Remarks:

Oil 3282.4000 acidP 8/11/10 8 1/220 hrs.

RECORD

Cased _____ in., _____ ft.

Sand _____

Gas _____

Oil _____

Total Depth 3299 1/2

PRODUCTION

1st 24 hrs. Nat. _____

1st 24 hrs. after shot _____

Gas _____ Cu. Ft.

Dry Hole _____

Abandoned _____

Date

MAY 27 1936

19

S. J. LEWIS

Scout