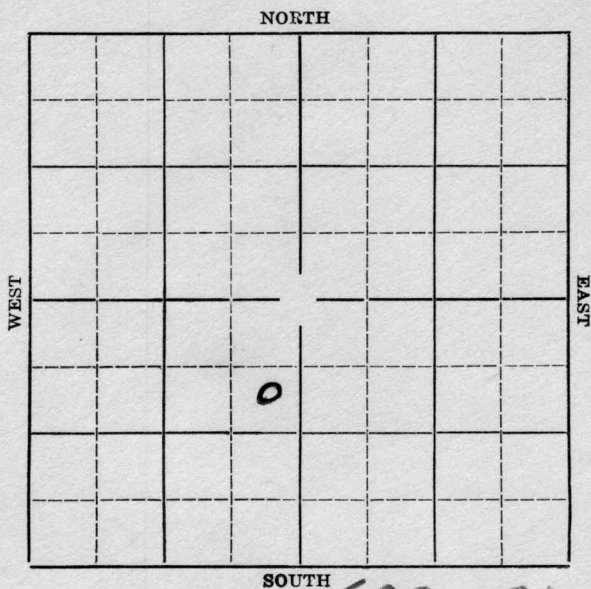


Section 14 Township 20 Range 11-WWell Number #2-LangfeldCompany Buchanan et alSPECIAL


Map No. **KANSAS** Sec. **14** Twp. **20** R. **11W**Well No. **#2 Langfield** Farm
Buchanan et al Company**990'** Ft. from N. Line

Ft. from S. Line

330' Ft. from E. Line

Ft. from W. Line

Elev. 1760

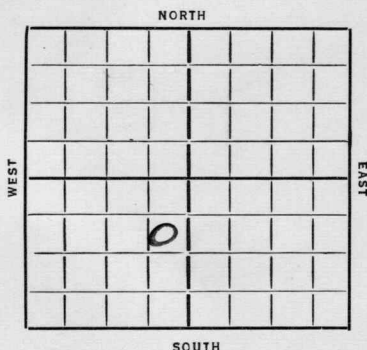~~1936~~
1936

REPORT

7/29 Building rig.**8/6 10" @ 196'. Drlg.****8/13 Drlg. 1540'.****8/20 Cored 3070' to 80'. TD. 7" @ 3072'.
Siliceous 3278'. 2' saturation.****8/27 Siliceous 3270'. CORRECTED. Drlg.
plug. Fitted up 3000' of oil in
30 minutes.****9/2/36-Sil. 3270'.****T.D. 3294'.****Pump 1540 bbls natural.****COMPLETED**

KANSAS

Map No. 46 Sec. 14 Twp. 20 R. 11WWell No. 2 LangfeldBuchanan & Dal Company

Contractor

SPECIAL

SECTION PLAT

990 Ft. from N. Line

_____ Ft. from S. Line

380 Ft. from E. Line

_____ Ft. from W. Line

FIRST REPORT

Location _____

Rig up _____

Drilling and Remarks:

Building rig

RECORD

Cased _____ in., _____ ft.

Sand _____

Gas _____

Oil _____

Total Depth _____

PRODUCTION

1st 24 hrs. Nat. _____

1st 24 hrs. after shot _____

Gas _____ Cu. Ft.

Dry Hole _____

Abandoned _____

Date

JUL 29 1935

S. J. LEWIS Scout

Map No. 46 Sec. 14 Twp. 20 R. 11W

Well No. 2 Langfeldt

Buckhogan & Daub Company

Contractor

SECTION PLAT

990 Ft. from N. Line

_____ Ft. from S. Line

330 Ft. from E. Line

_____ Ft. from W. Line

COMPLETED

Location _____

Rig up _____

Drilling and Remarks:

Sil 3270

Pump 1540 ft
Nat.

RECORD

Cased _____ in., _____ ft.

Sand _____

Gas _____

Oil _____

Total Depth 3294

PRODUCTION

1st 24 hrs. Nat. _____

1st 24 hrs. after shot _____

Gas _____ Cu. Ft.

Dry Hole _____

Abandoned _____

Date

SEP 2 1936 19

S. J. LEWIS

Scout